


T. 1N., R. 19E., W.M.

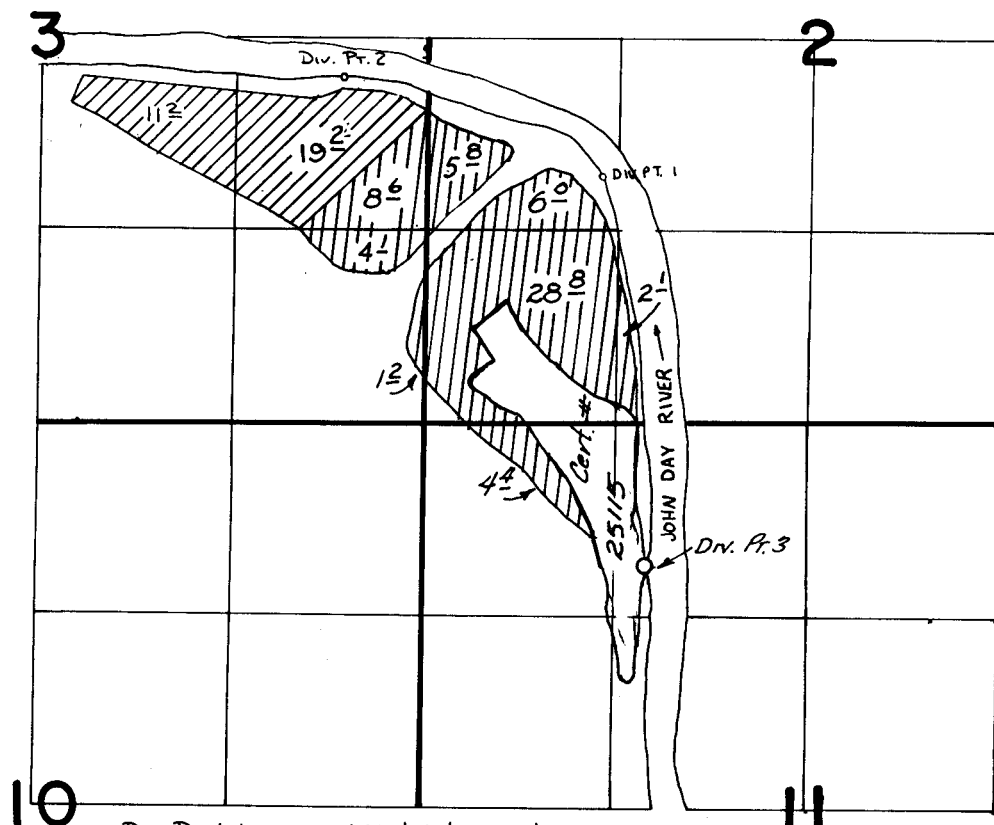

Div. Pt. 1 LOCATED 1700' N. & 1200' E. FROM SW COR. SEC 2

Div. Pt. 2 LOCATED 2380' N. & 560' W FROM SW COR. SEC 2

Div. Pt. 3 LOCATED 340' N. & 230' E FROM NW $\frac{1}{16}$ COR. SEC 11

N

Scale 1" = 1320'

FINAL PROOF SURVEY

UNDER

47876

35877 (re mapped)

TRANSFER 2473

Application No. 58046 Permit No. 43721....

IN NAME OF

BIG SKY RANCH, INC.

Surveyed May...20. 1985., by V. Church.....

revised 10/8/98

179-77L

SC