


T. 30 S., R. 4 W., W.M.

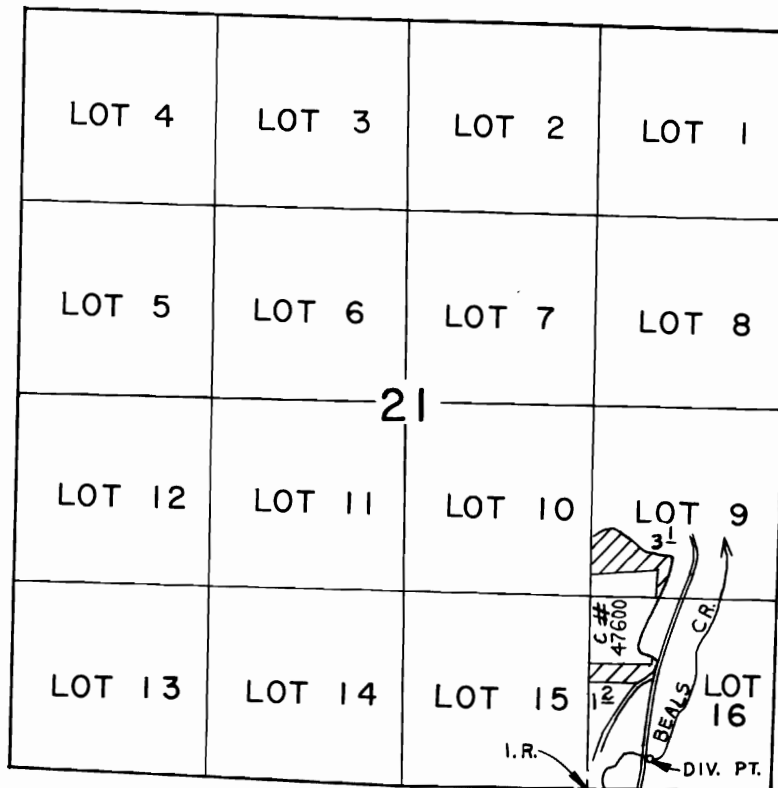

DIV. PT. LOCATED 215' N. & 835' W. FROM S.E. COR. SEC. 21

SCALE: 4" = 1 mile

FINAL PROOF SURVEY
UNDER

T-4848

Application No. 61934 Permit No. 46275

IN NAME OF

GEORGE M. HAYTER

Surveyed AUG. 16, 1983, by J. S. DONALDSON