
## T.45.R.3 W.W.M.

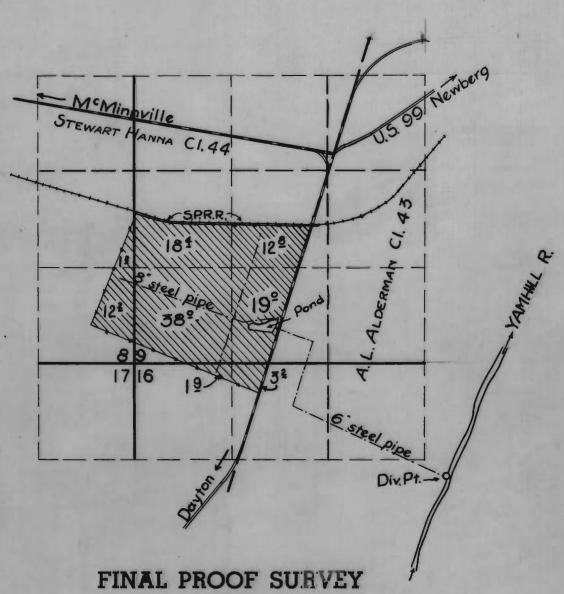

UNDER

Application No. 22945 Permit No. 18125 IN NAME OF

KEITH F. COBURN

Surveyed 2 June 1955 by T. Jones