


T.4N.R.34E.W.M.

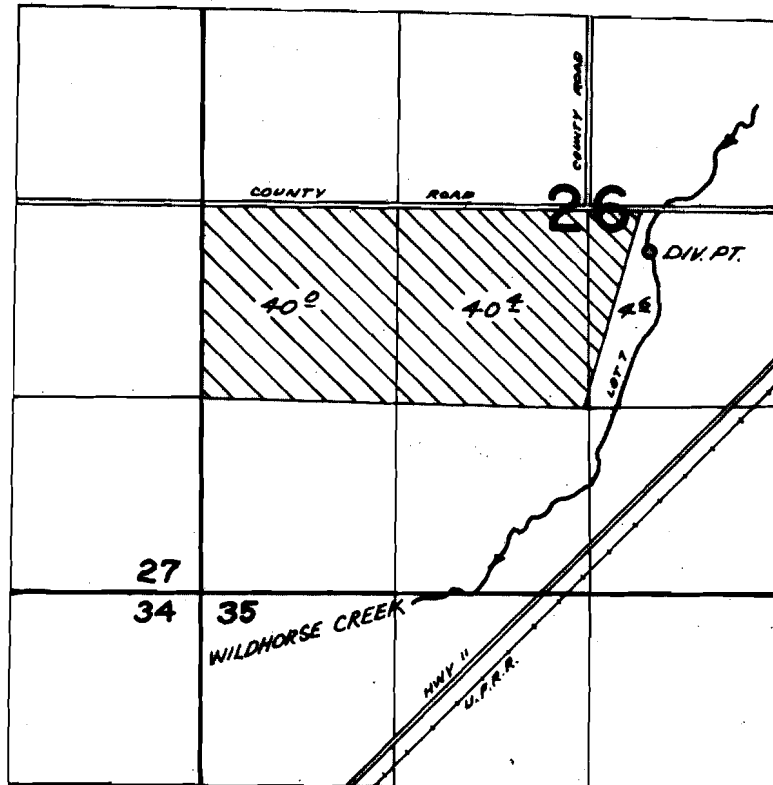

DIV. PT. LOCATED 310 FT. S. AND 420 FT. E. FROM CENTER SEC. 26

FINAL PROOF SURVEY
UNDER

Application No. 42169 Permit No. 31557
IN NAME OF

B.L. DAVIS RANCH, INC.

Surveyed APR. 10 1973, by D.M. NORBY