


*Irrigation Ditch Survey
in
N.E. $\frac{1}{4}$ of Section 36, T. 8 S.,
R. 22 E. W. M.*

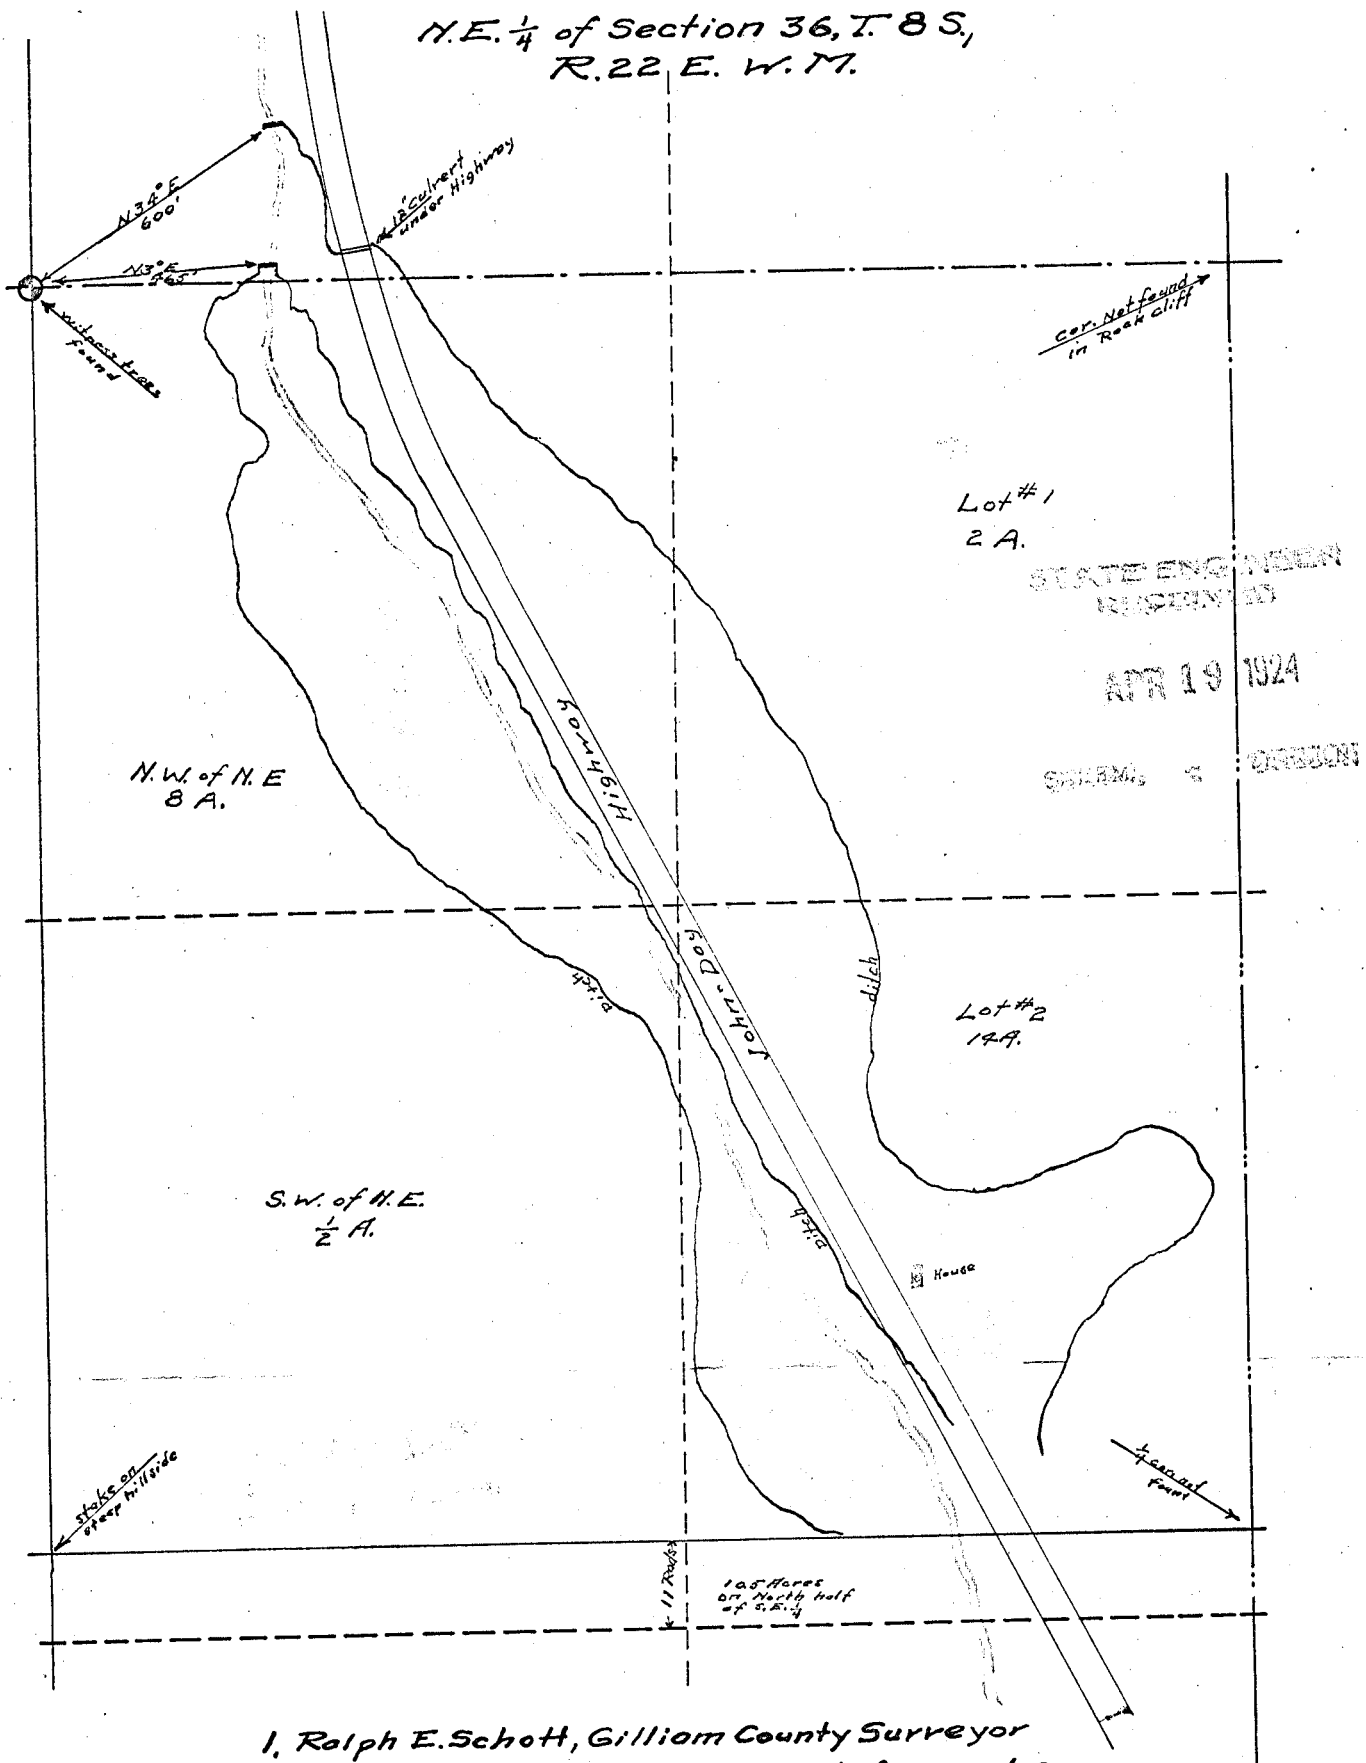

I, Ralph E. Schott, Gilliom County Surveyor
do hereby certify that this map was made from notes
taken during an actual Survey made by me on
April 5, 1924, and that it correctly represents the
works described in the accompanying application,
together with the location of Streams and other
ditches in the immediate vicinity.

Ralph E. Schott
C. Surveyor.

Scale: 1 in. = 400 ft.

2464