


T. 1 N. R. 3 W. W.M.

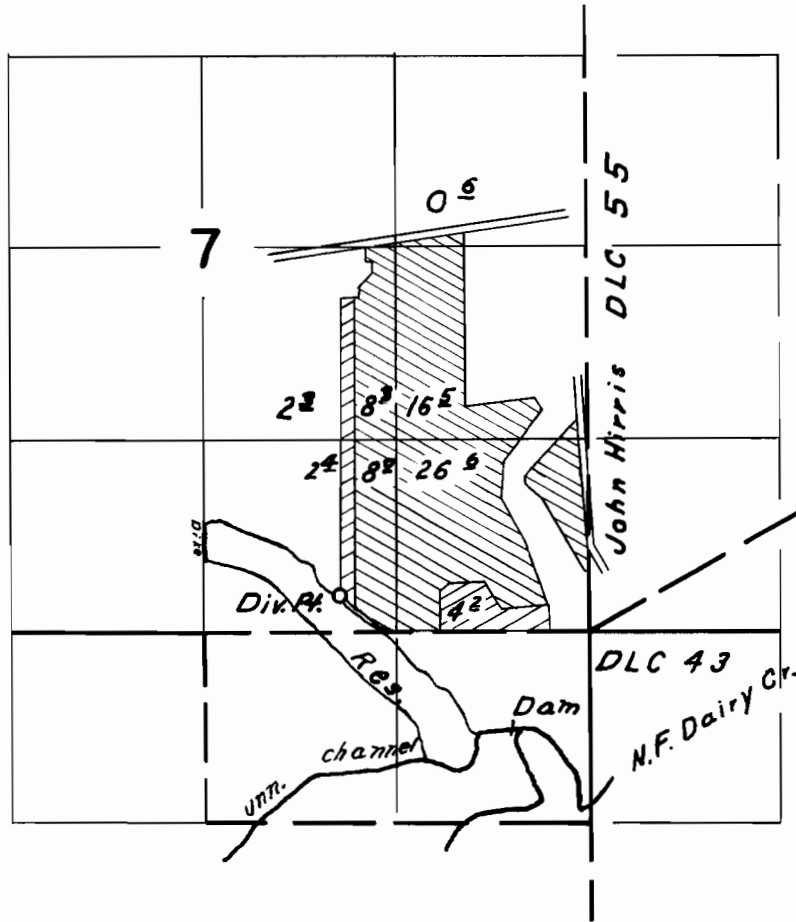

**FINAL PROOF SURVEY**  
UNDER

Primary  Suppl. 

R-29603 R-1834  
Application No. 29785 Permit No. 24065  
IN NAME OF

*Louis M. Spiering*

Surveyed April 30 1958, by R. H. Whitby