


T.9S. R. 23 E. W.M.

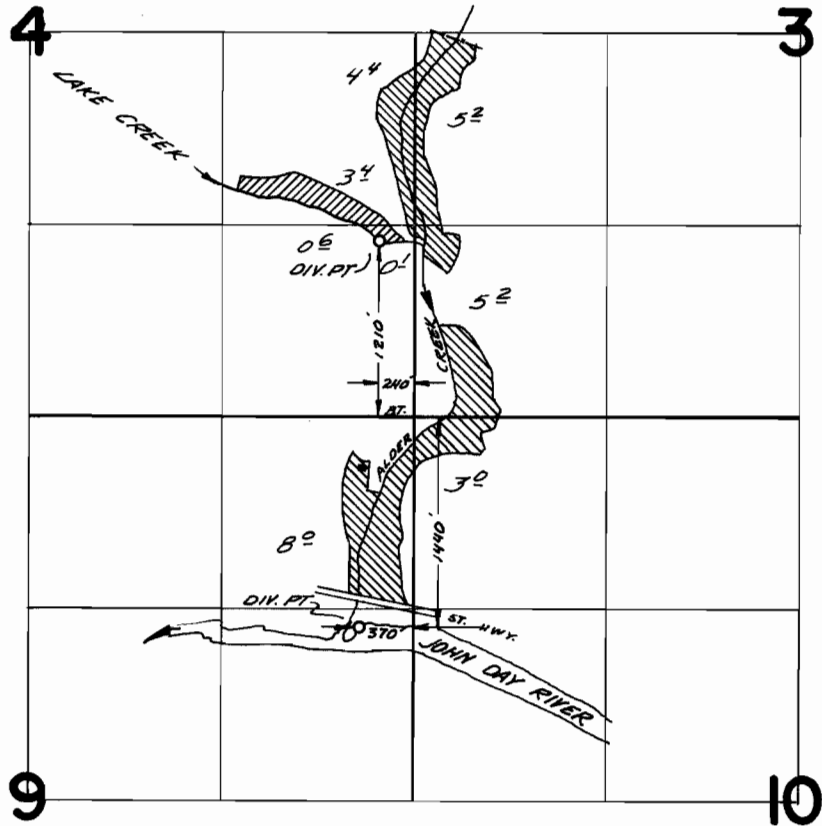

**FINAL PROOF SURVEY**  
UNDER

Application No. 40468... Permit No. 30159...  
IN NAME OF

*TRIPLE L. RANCHES, INC.*

Surveyed July 15, 1968, by *V. Garner*