


Application No. ^{R-49} 72750
Permit No.

FINAL PROOF MAP

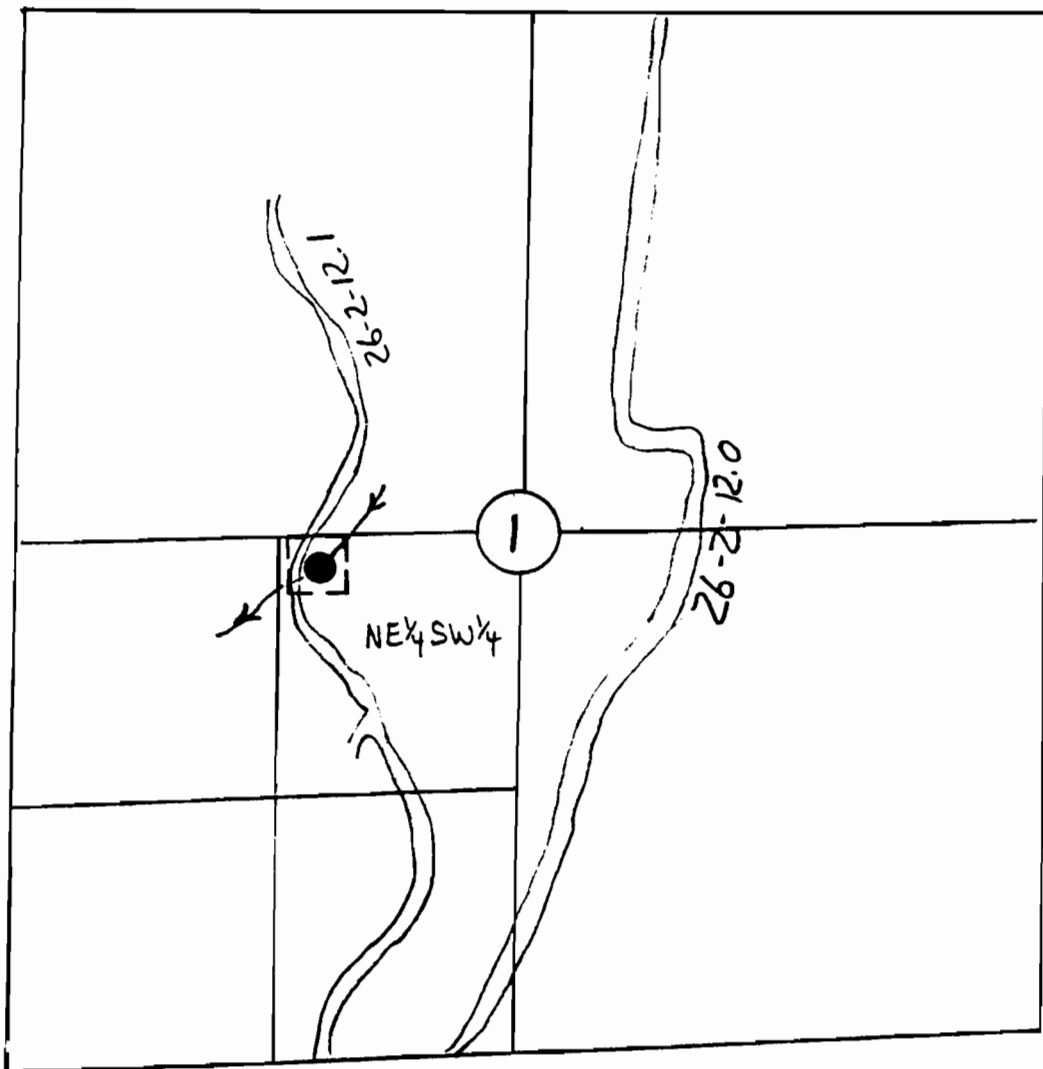


Scale 1"=1000'

BURNT
T26S R2W Sec 1
NE 1/4 SW 1/4

The point of diversion is located approximately 2650 ft North and 1600 ft East from the Southwest Section Corner of Section 1.

Coordinate Ties are based on aerial photo

The map is shown for the purpose of water application and not property boundary.

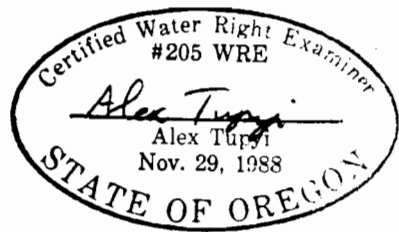

9-17-92