


Application No. R-727521

Permit No.

FINAL PROOF MAP

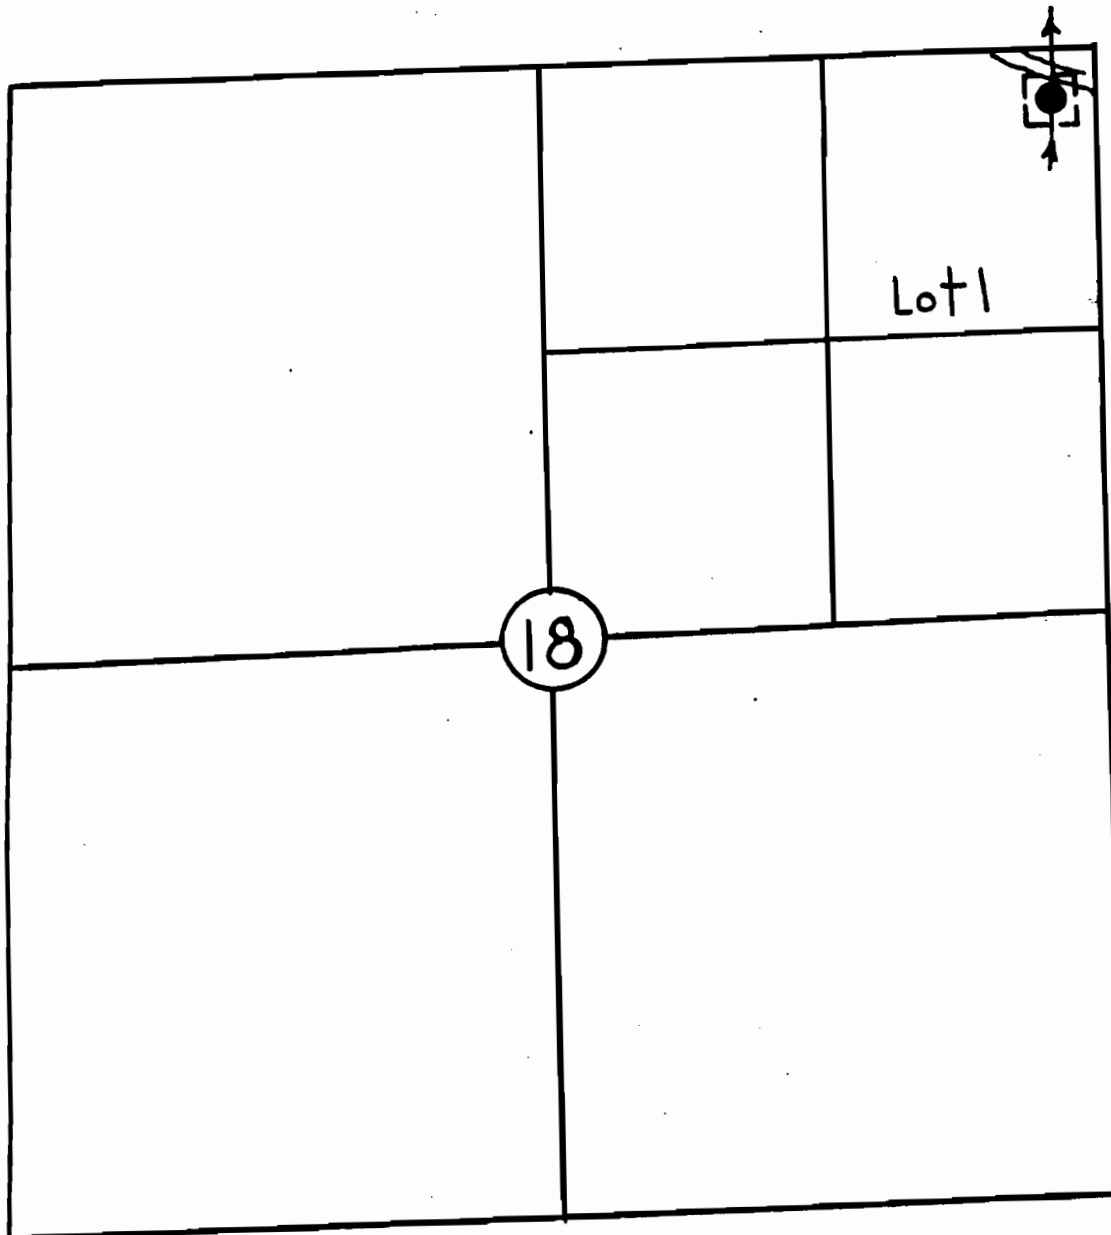

Scale 1"=1000'

BROKEN BENCH
T27S R2W Sec 18
Lot 1

The point of diversion is located approximately 260 ft South and 210 ft West from the Northeast Section Corner of Section 18.

Coordinate Ties are based on aerial photo

The map is shown for the purpose of water application and not property boundary.

