


Application No. ^R72754/3 FINAL PROOF MAP

Permit No.

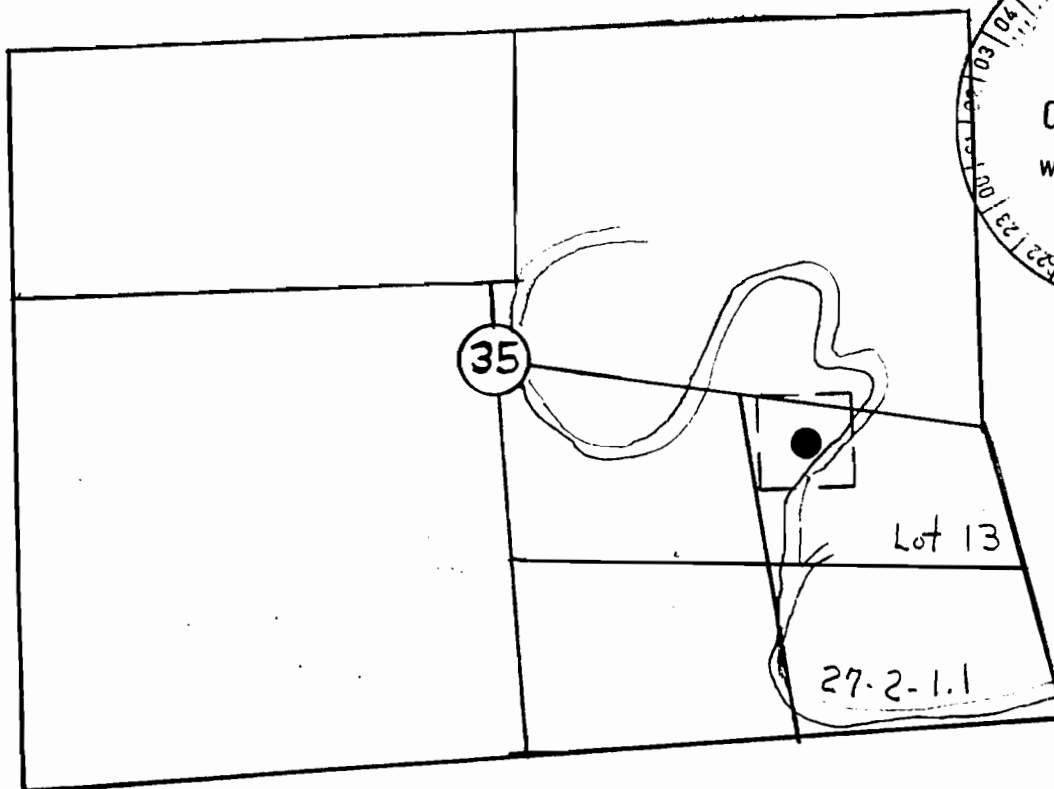


BOG BUSTER POND
T26S R2W Sec 35
Lot 13

The point of diversion is located approximately 1450 feet North and 1300 feet West from the Southeast Section Corner of Section 35.

Coordinate Ties are based on aerial photo 8-45A-20.

This map is shown for the purpose of water application and not property boundary.

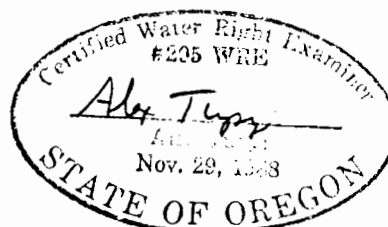

2-24-92