
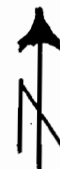


Application No. 727545
Permit No.

FINAL PROOF MAP

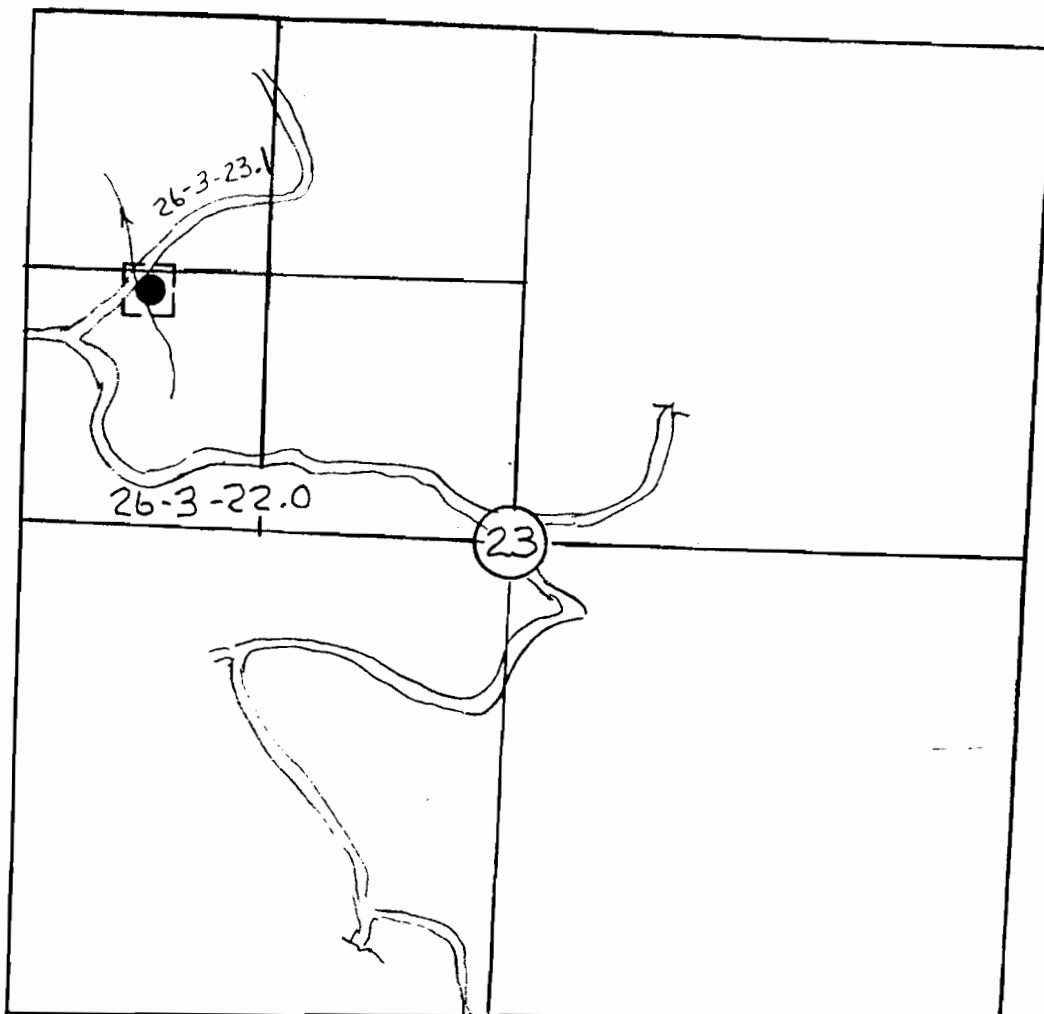


Scale 1" = 1000'

BASCO'S BOWL POND
T26S R3W Sec 23
SW $\frac{1}{4}$ NW $\frac{1}{4}$

The point of diversion is located approximately 1400 feet South and 700 feet East from the Northwest Section Corner of Section 23.

Coordinate Ties are based on aerial photo 7-39A-4.

This map is shown for the purpose of water application and not property boundary.

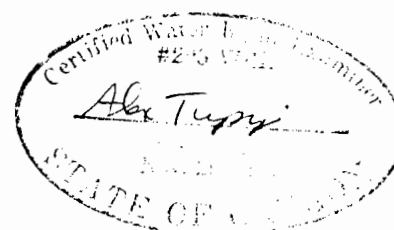

3-16-92