


Application No. 727587

Permit No.

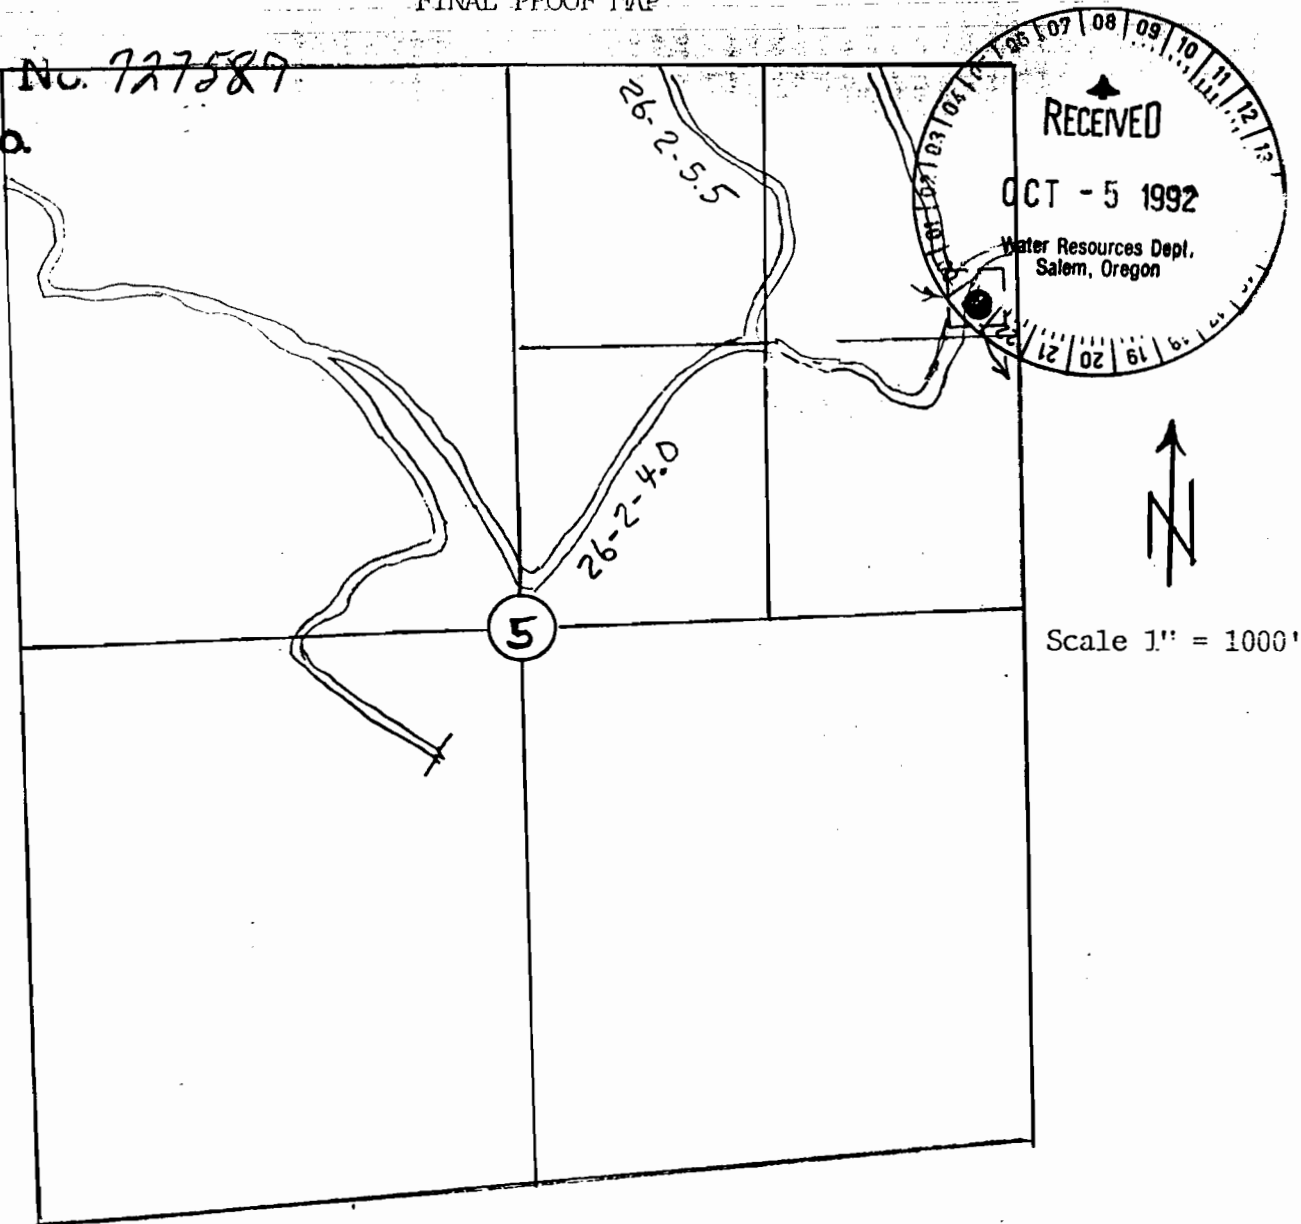


WATSON'S FOLLY POND
T26S R2W Sec 5
Lot 1

The point of diversion is located approximately 1150 feet South and 200 feet West from the Northeast Section Corner of Section 5.

Coordinate Ties are based on aerial photo 7-42B-16.

This map is shown for the purpose of water application and not property boundary.

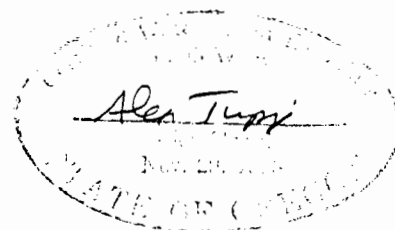

3-16-92