
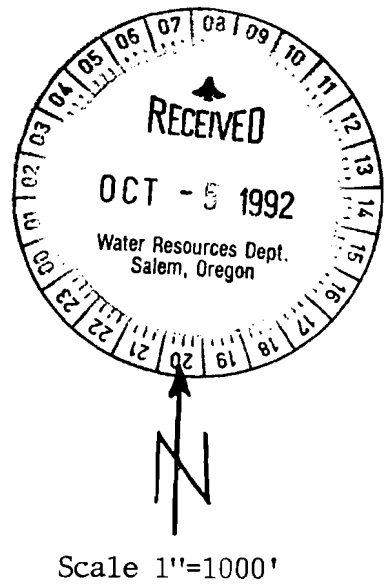


Permit No.

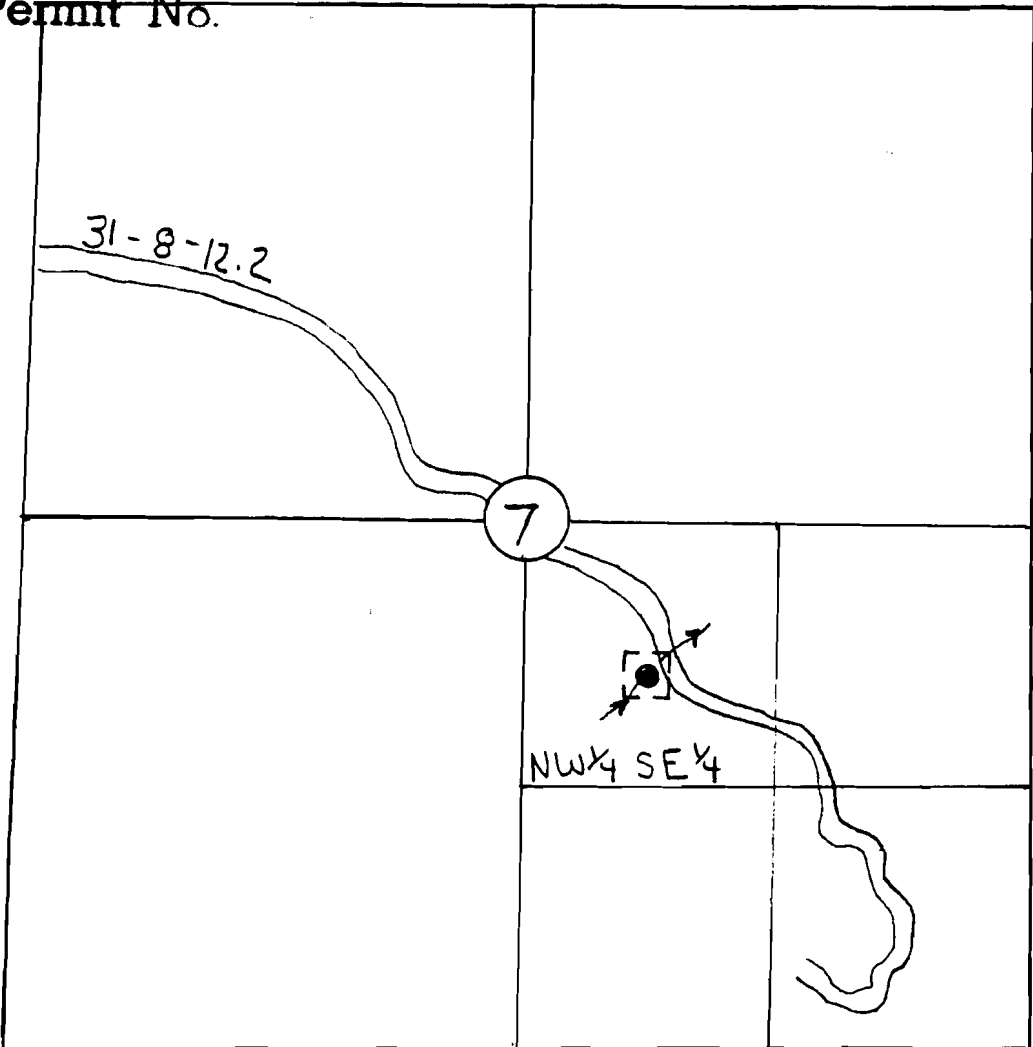


OLE DAD'S PUMP CHANCE
T31S R7W Sec 7
NW¹/₄ SE¹/₄

The point of diversion is located approximately 1900 ft North and 1900 ft West from the Southeast Section Corner of Section 7.

Coordinate Ties are based on aerial photo 1-11-13.

The map is shown for the purpose of water application and not property boundary.

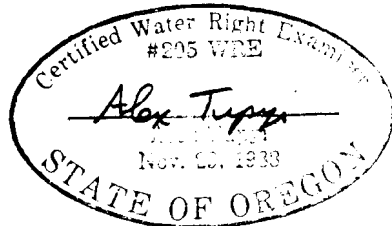

9-17-92