


RECEIVED
AUG 12 1996
WATER RESOURCES DE
SALEM OREGON

Topo map - Zumwalt, Oregon
Scale: 1:24000 T2N, T3N, R47E
1990 Edition

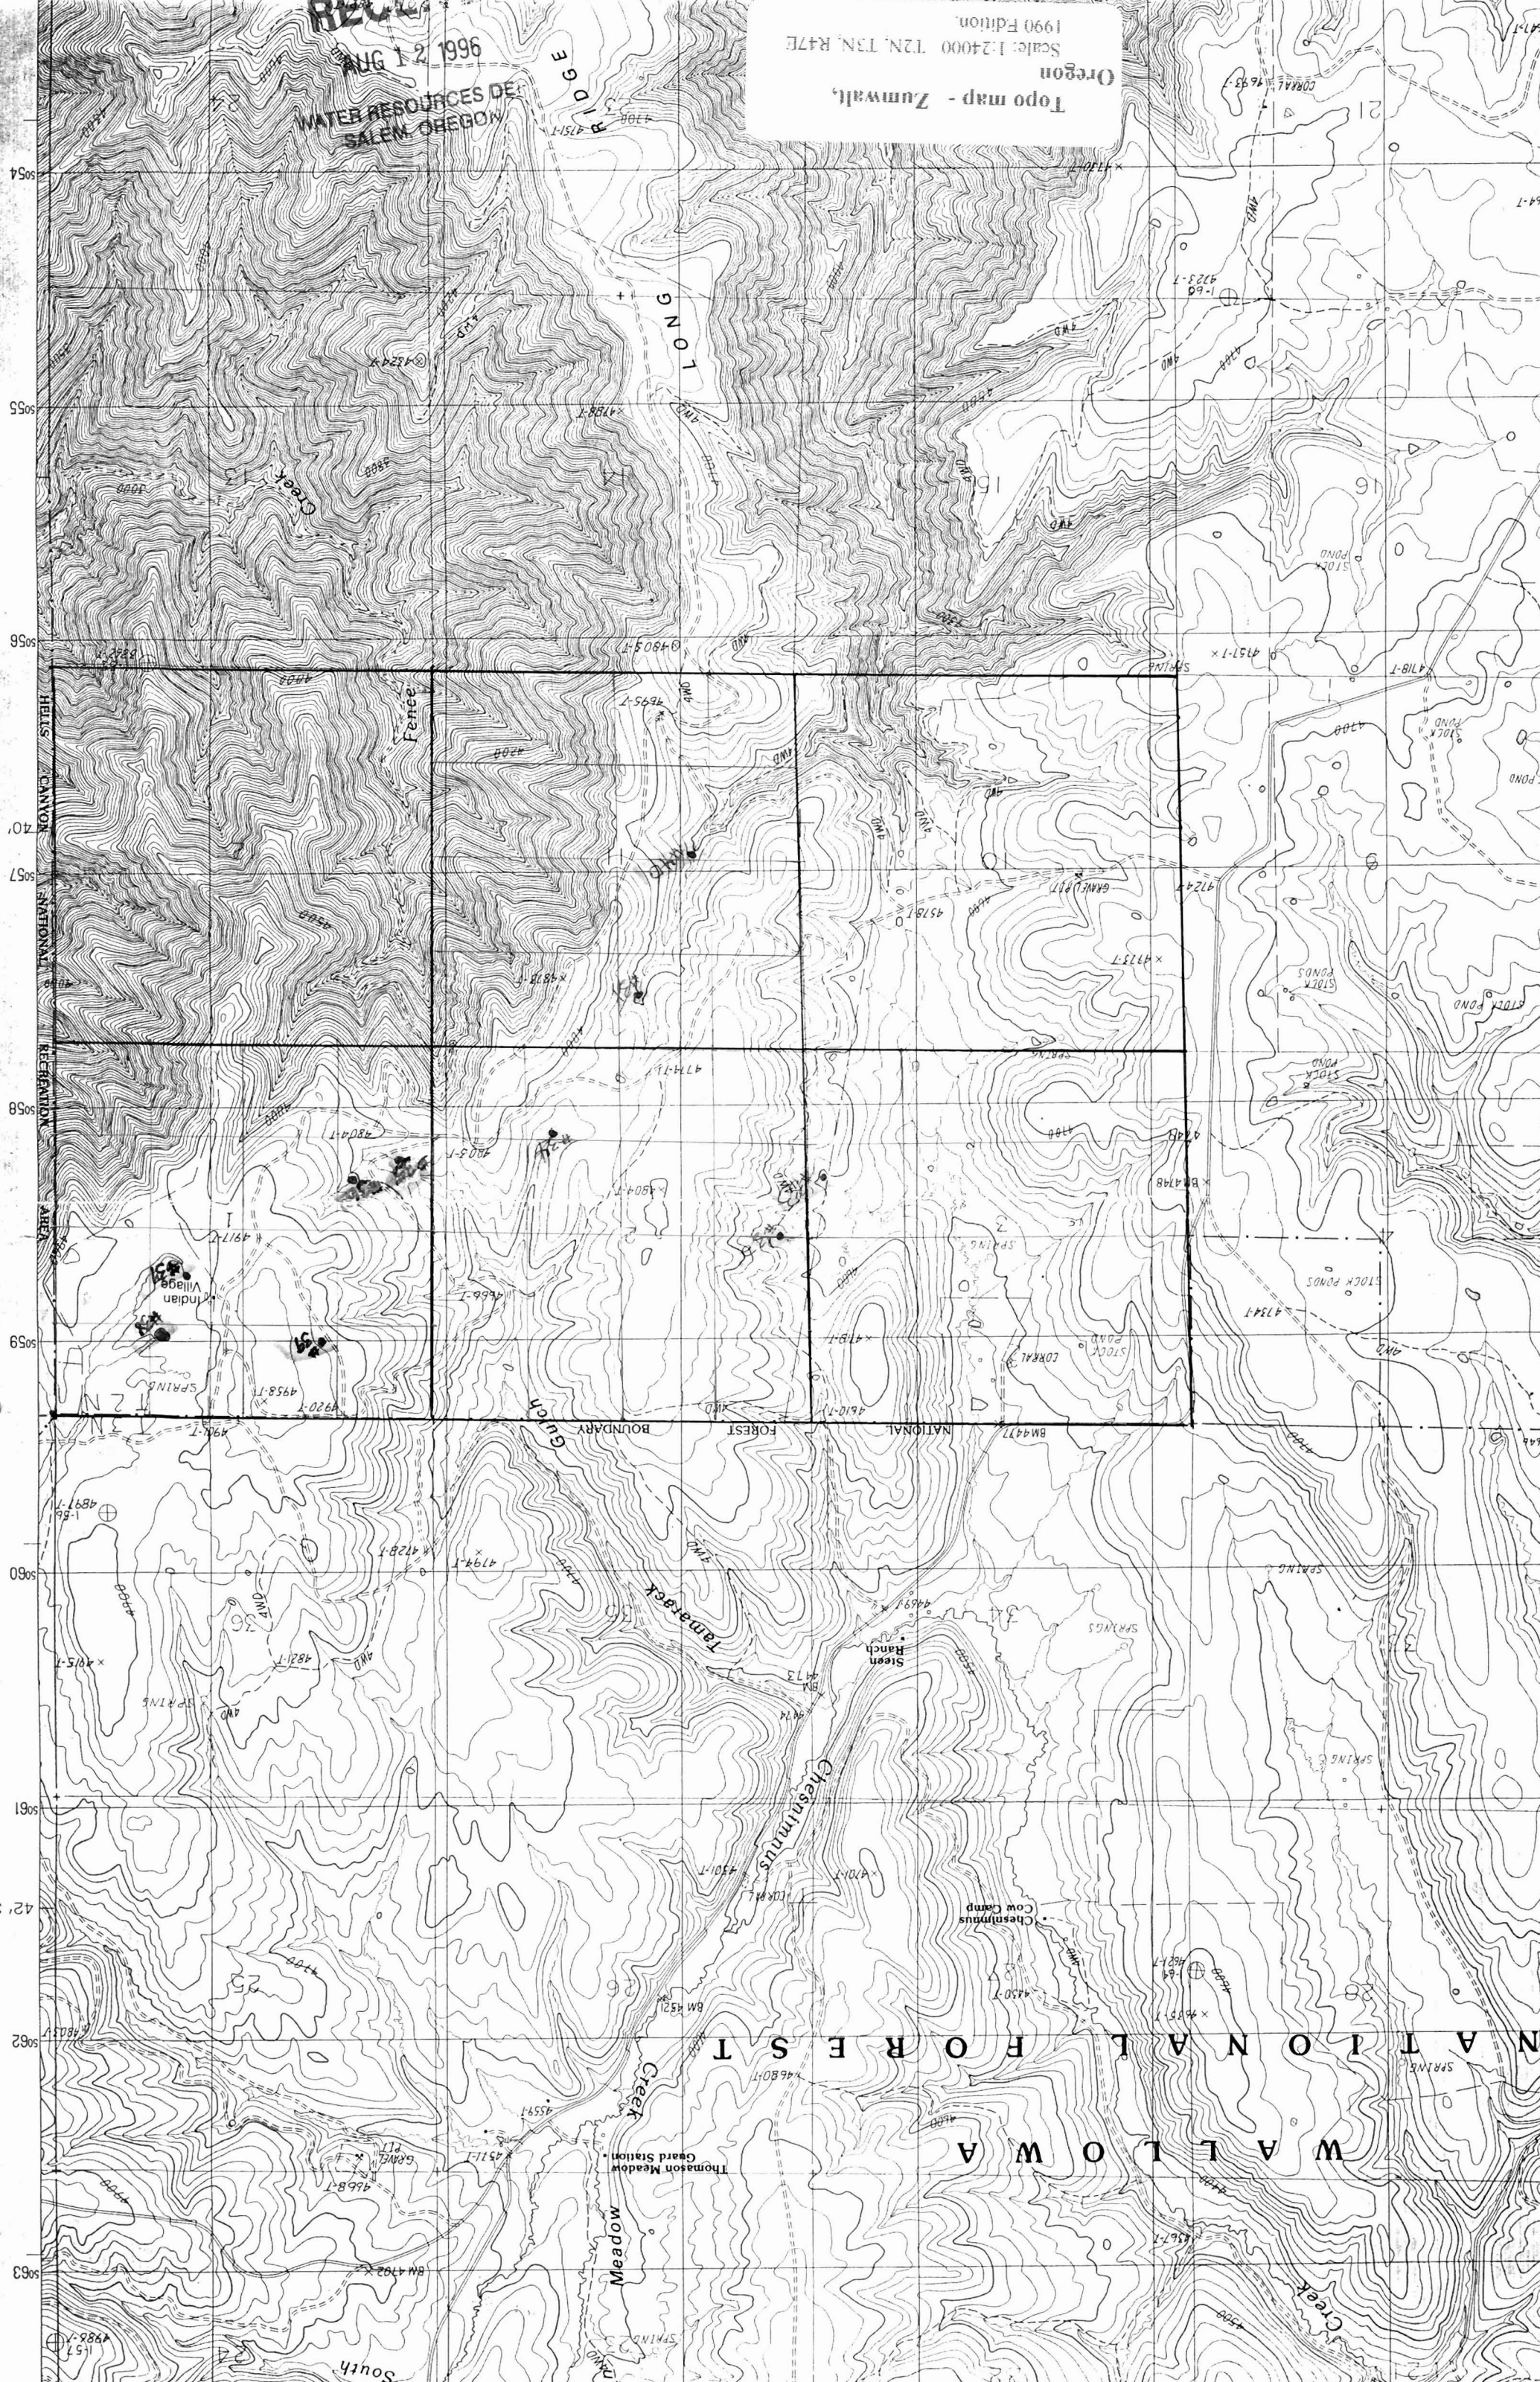

No Final Proof Map available

No Permit Map available