


Application No. ^R7276³ FINAL PROOF MAP
Permit No.

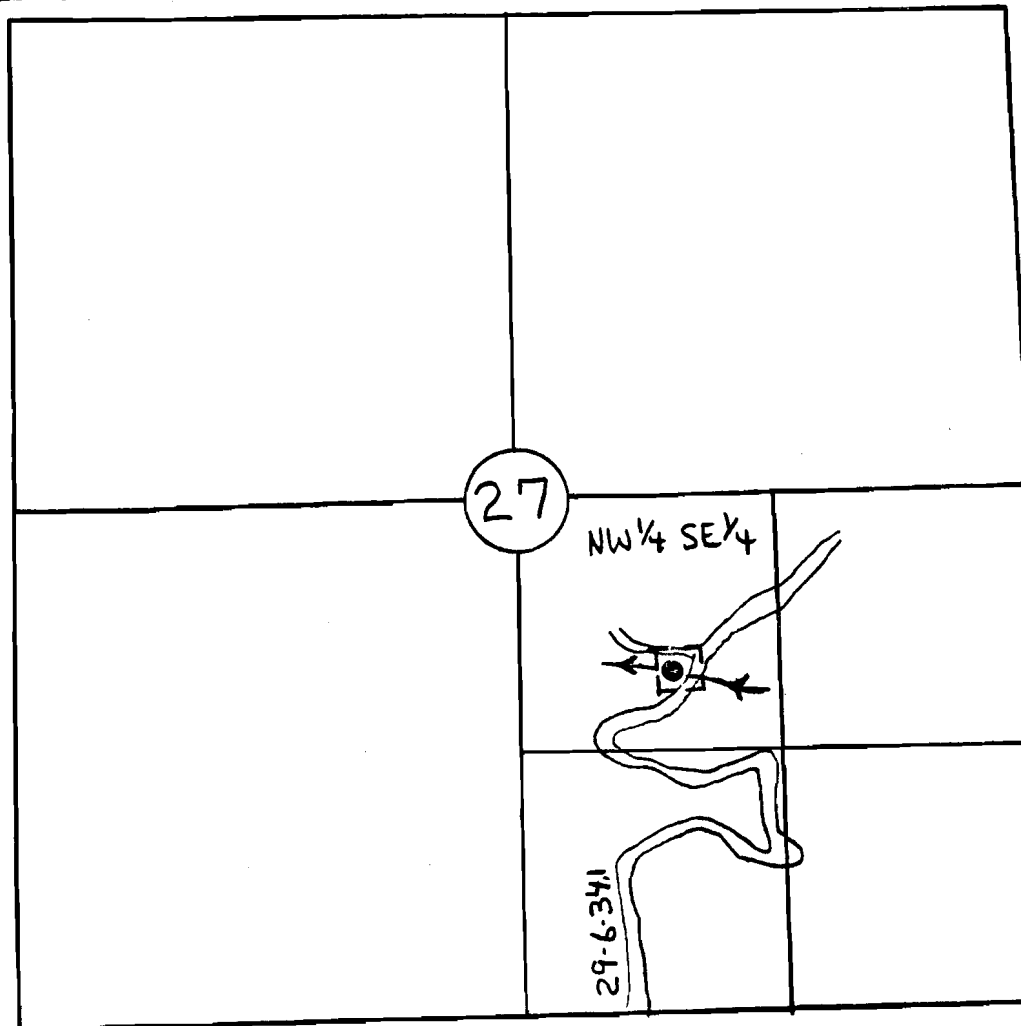


Scale 1"=1000'

ONE BUCKET
T29S R6W Sec 27
NW $\frac{1}{4}$ SE $\frac{1}{4}$

The point of diversion is located approximately 850 ft South and 800 ft East from the center hub of Section 27.

Coordinate Ties are based on aerial photo 16-20-24.

The map is shown for the purpose of water application and not property boundary.

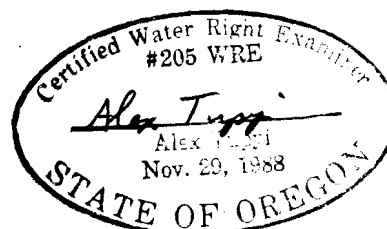

9-17-92