


T.14S.R.15E.W.M.

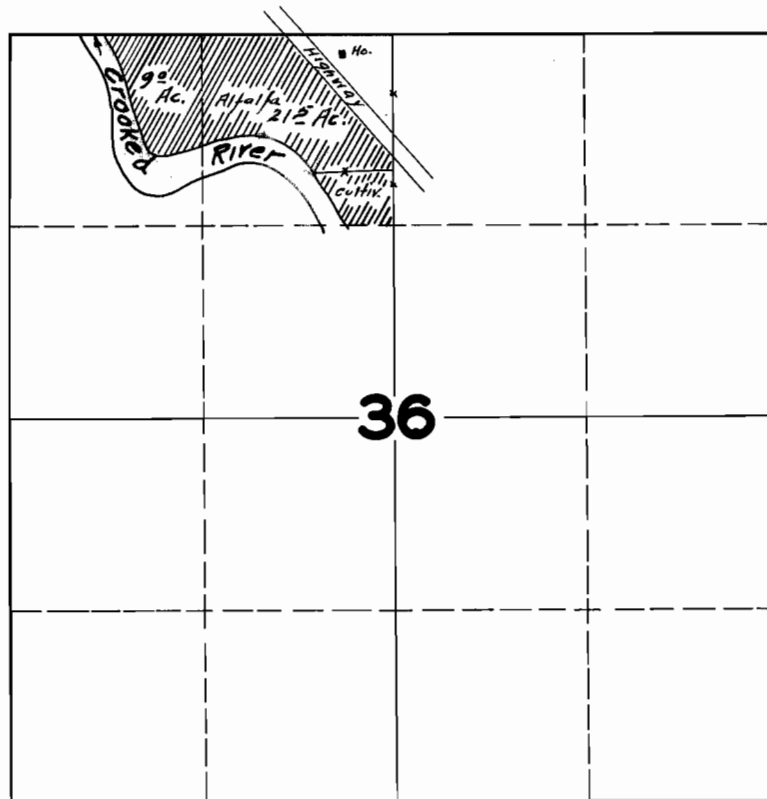

FINAL PROOF SURVEY UNDER

Application No. 18798 Permit No. 14439

IN NAME OF

J. ASCHBACHER

Surveyed APR. 28 1947, by JAS. E. BUNNELL