Application No. 68836
Permit No. 49773


RECEIVED
AUG 2 6 1986
WATER RESOURCES DEPT.
SALEM, OREGON

PLAT of SURVEY

East Line of W½ NW¼ Sec. 1, T12S, R8W, W.M.
Surveyed for John Chambers
J. Robeson

5998

SCALE: 1" = 300' Nov. 5, 1974
Basis of Bearings = C.S. #3460

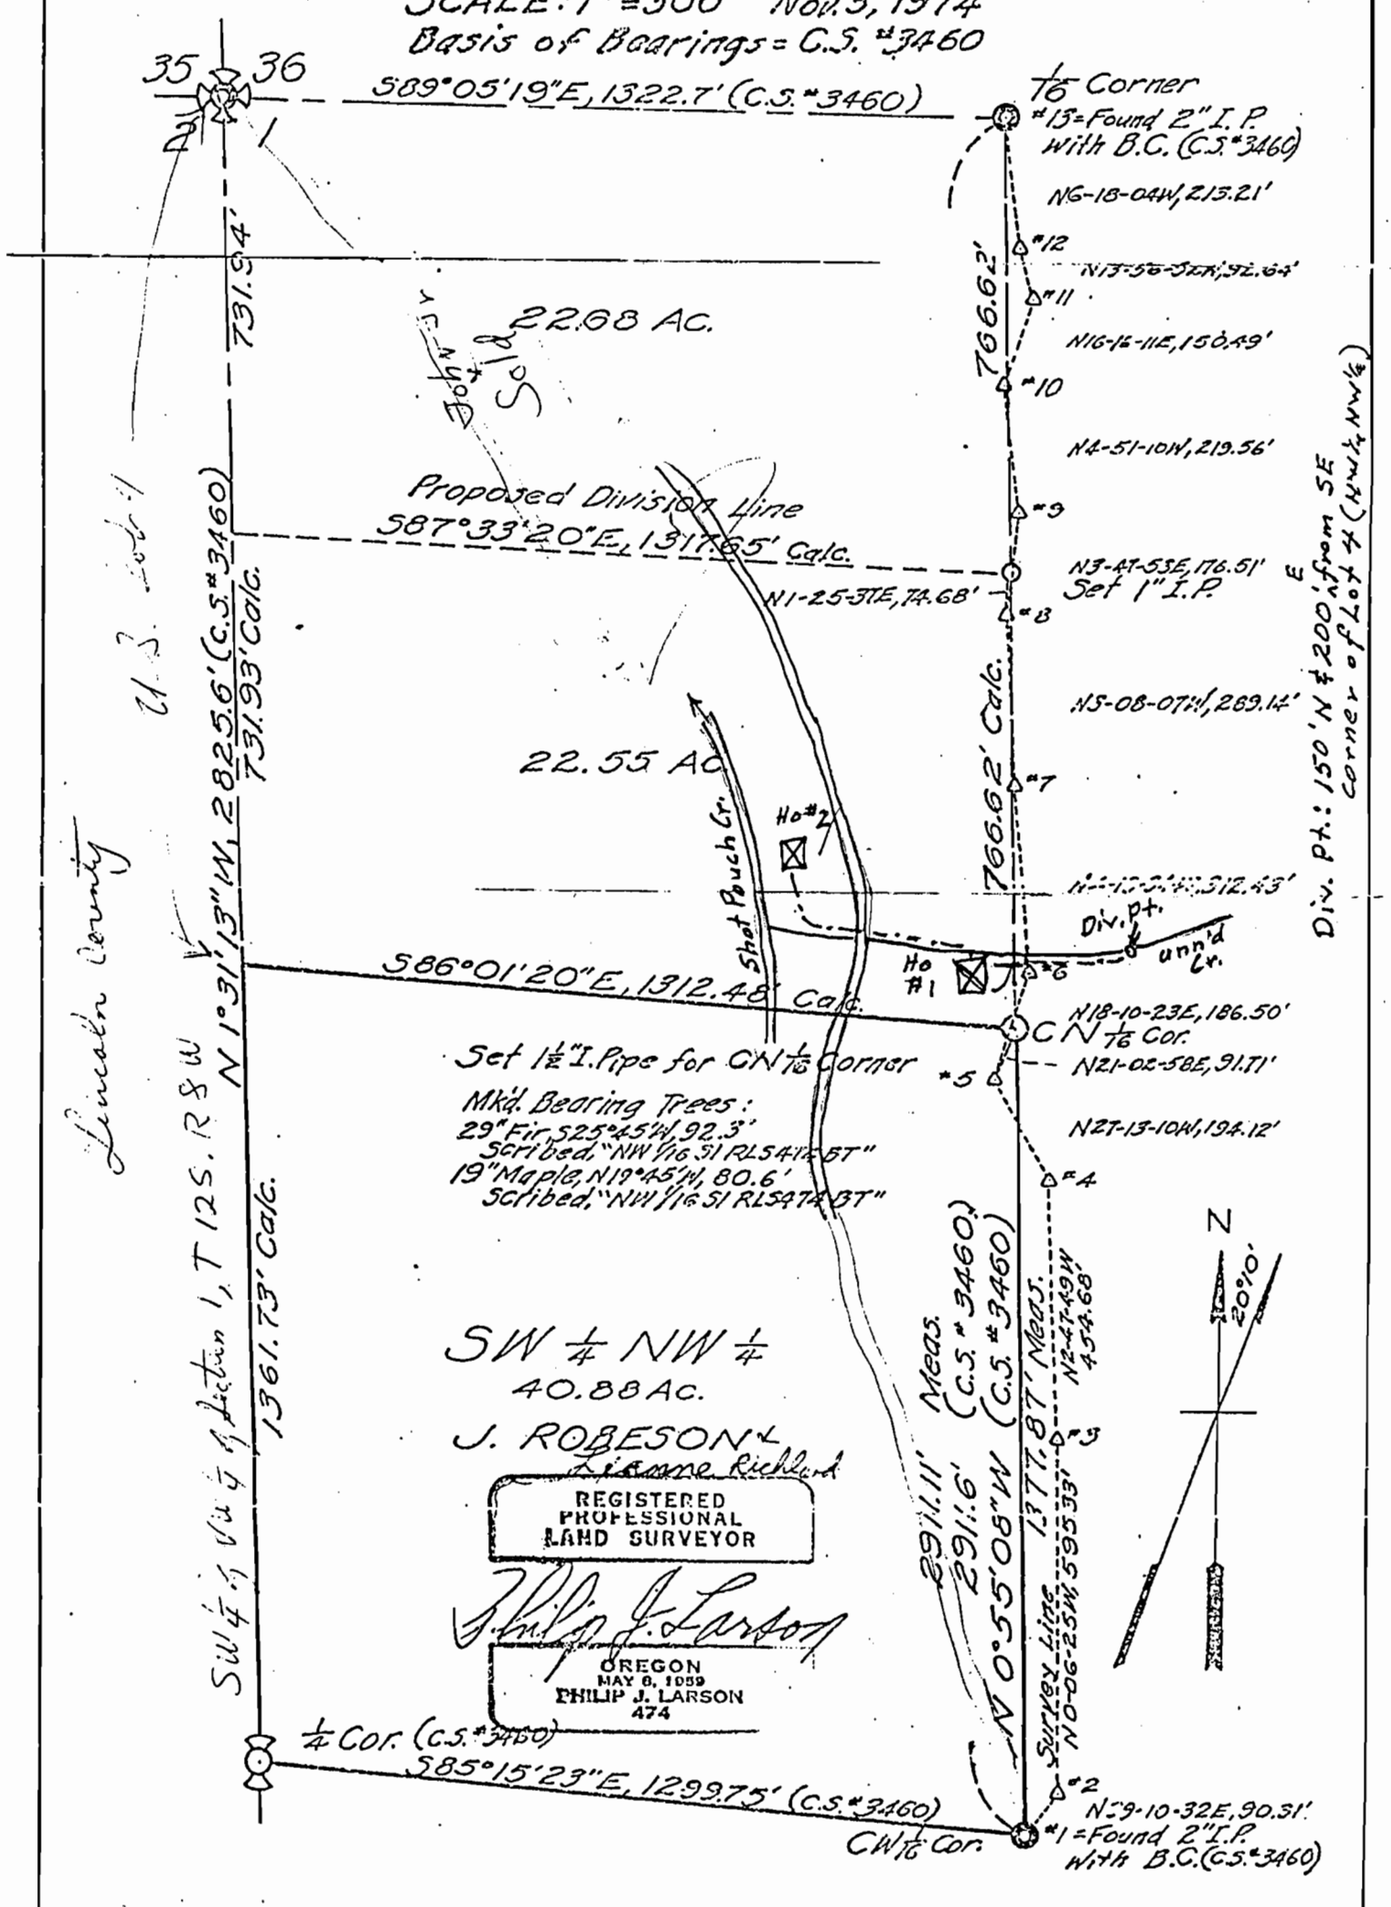

Survey by Philip J. Larson