


T.28S. R.6W.W.M.

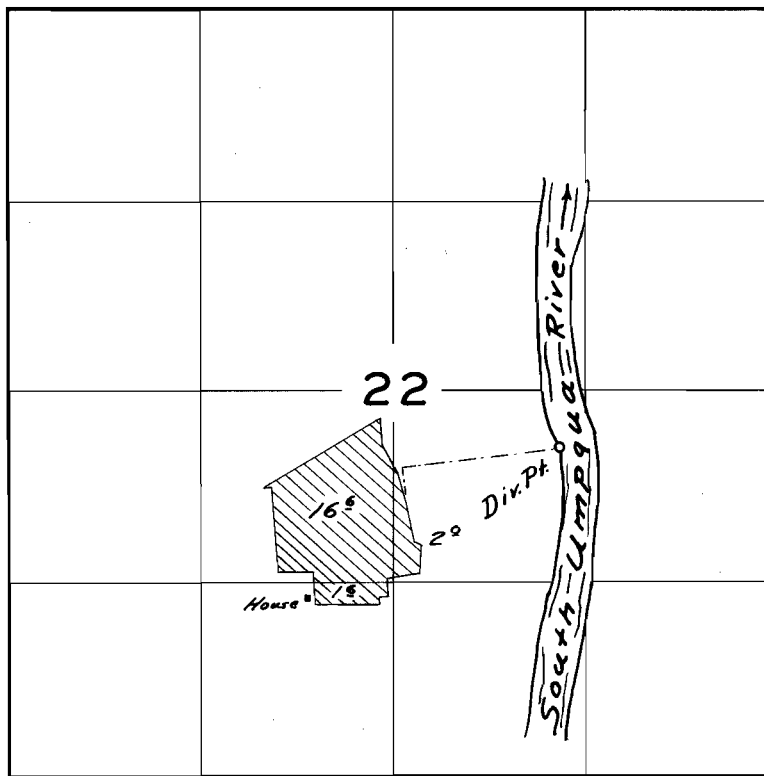

**FINAL PROOF SURVEY**  
UNDER

Application No. 27776 Permit No. 21867  
IN NAME OF

Jay L. Hooten

Surveyed July 31 1956, by C.D. Bastela