

Cecilia M. Taylor
Richard A. Taylor
HE250 and
Permit 50233
Map
Scale: 8" to the mile

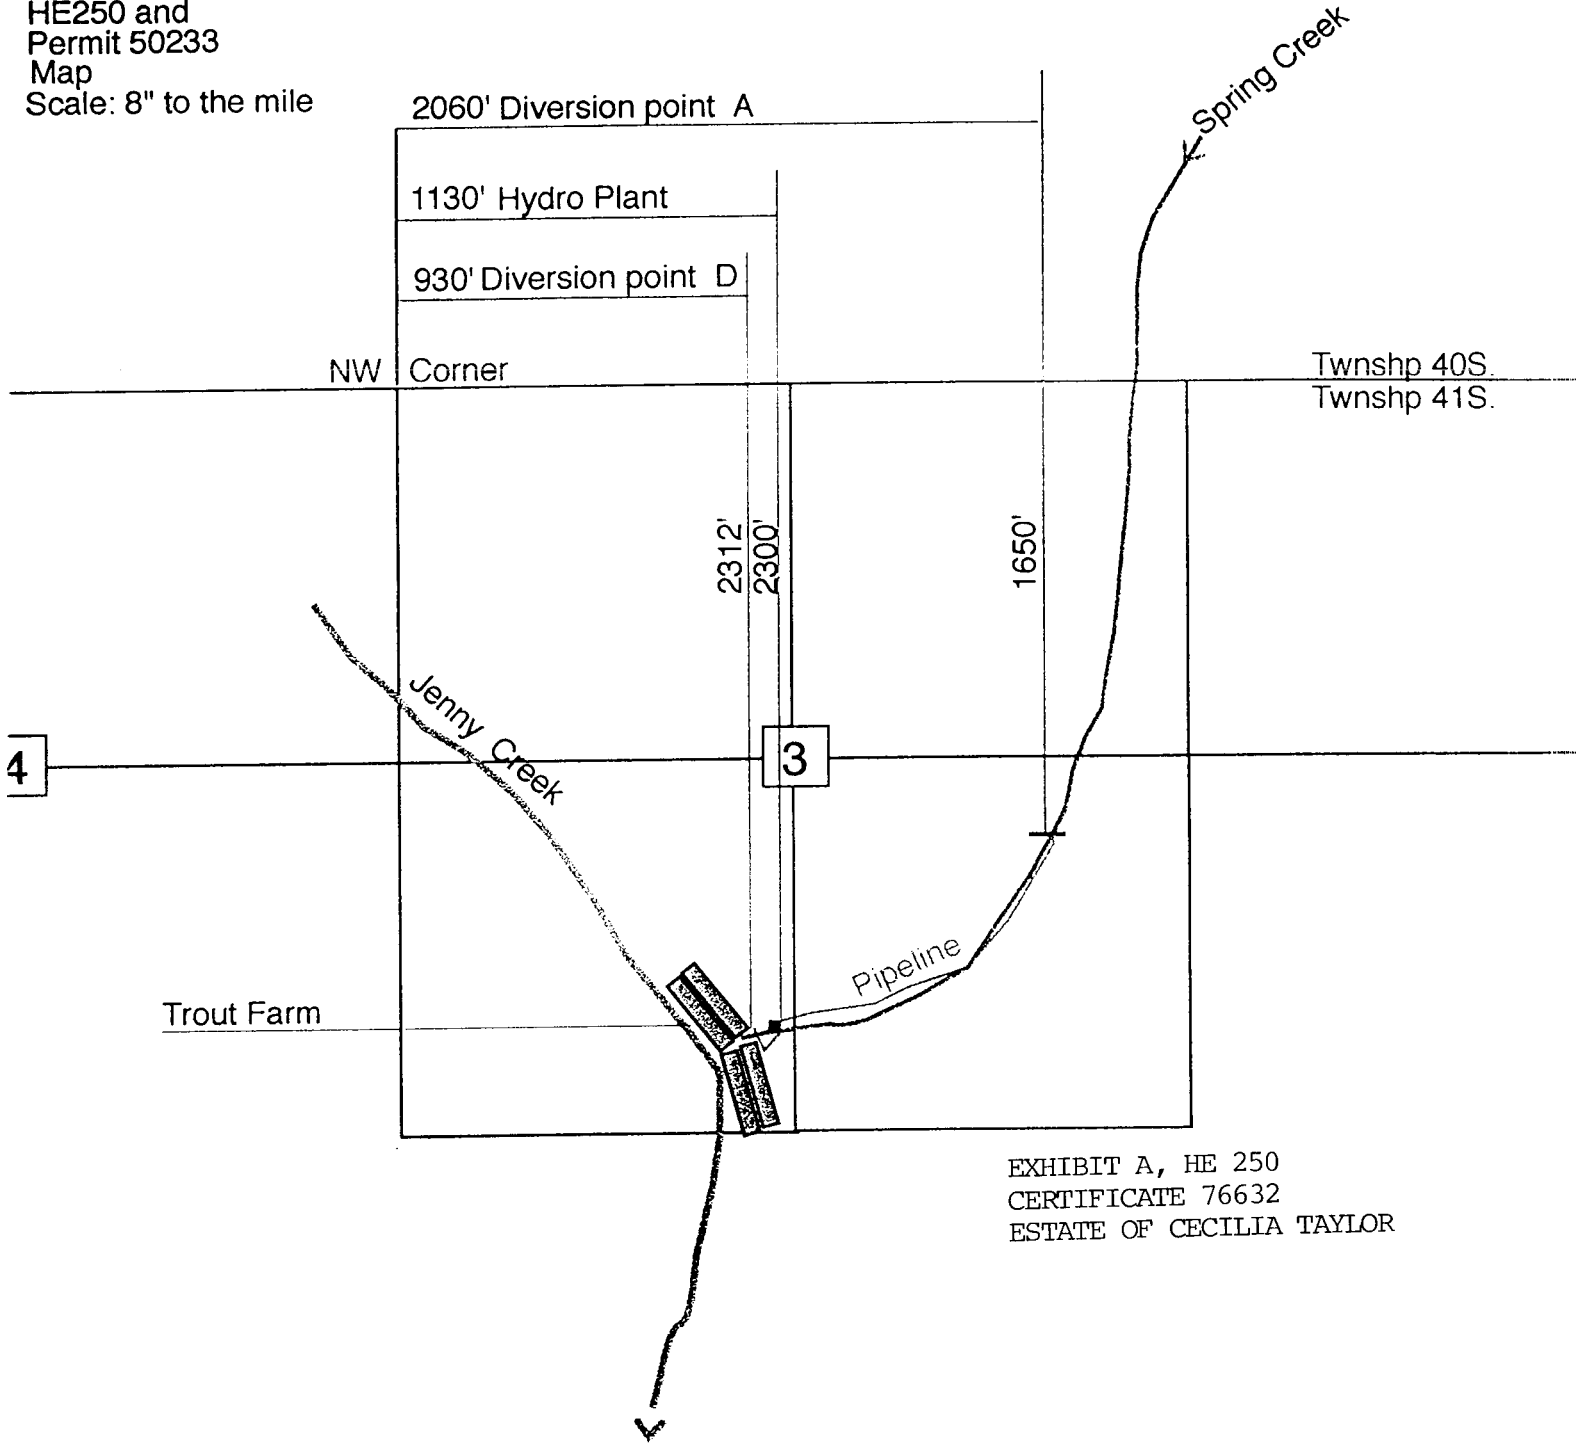


EXHIBIT A, HE 250
CERTIFICATE 76632
ESTATE OF CECILIA TAYLOR