


T.2S. R.1W.&1E. W.M.

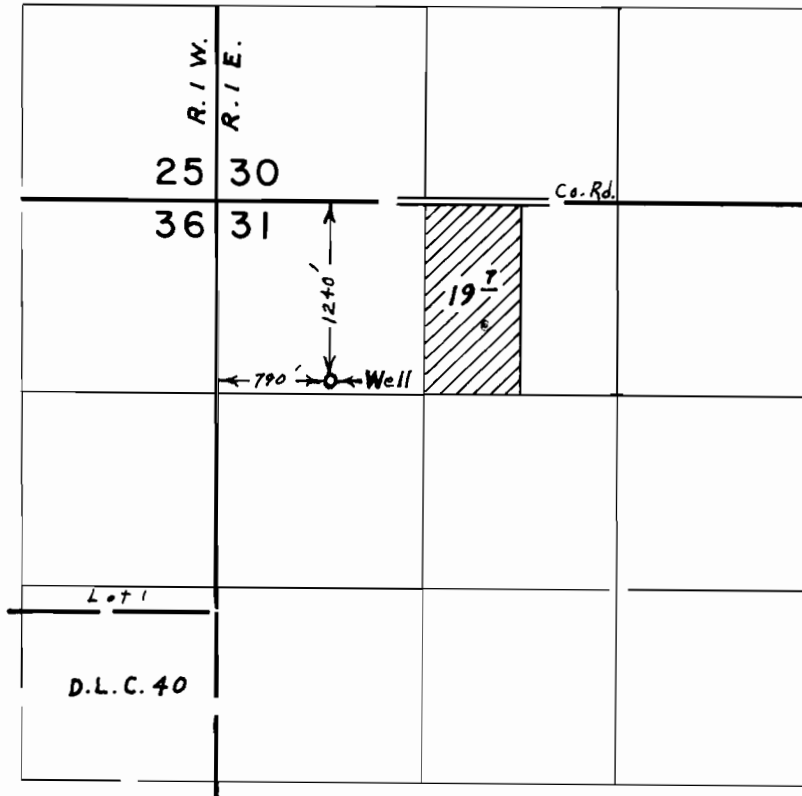

FINAL PROOF SURVEY UNDER

Application No. G-7258 Permit No. G-6656
IN NAME OF

GENE L. WILHELM

Surveyed June 3, 1976, by L. E. Gould