
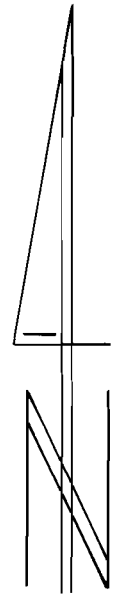


T. 1 S., R. 3 W., W.M.

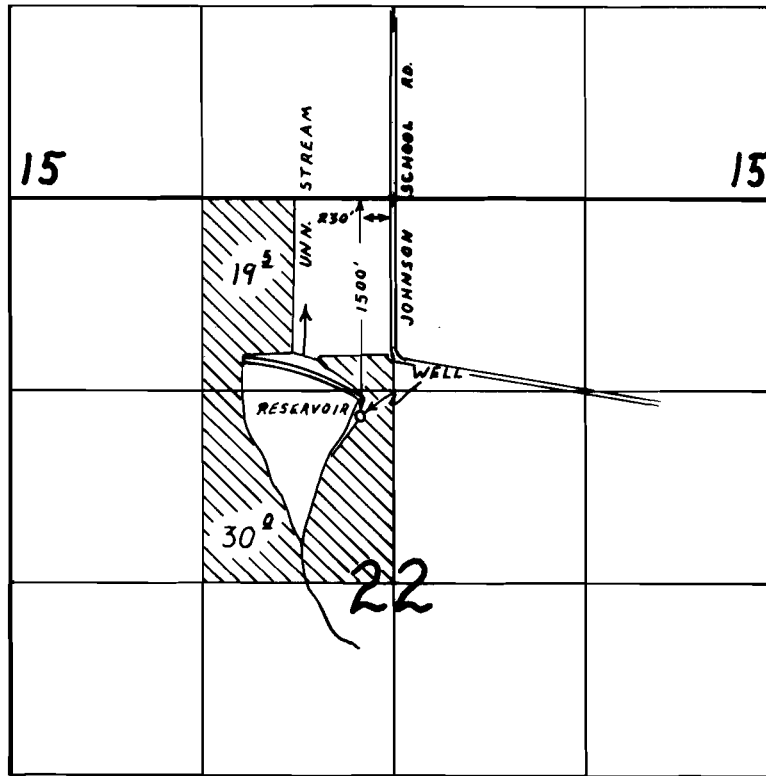

1" = 1320'

FINAL PROOF SURVEY

UNDER

R-63765

63766

Application No. G-11675

IN NAME OF

R-8515

47083

Permit No. G-10810

Glenn Walters Nursery, Inc.

Surveyed July 15, 1993, by R.W. Klassen

July 27, 88 by T. Klassen

Revised 2/24/00 SB

41067 489 110L RWK 10/11/93