


T.2S.R.2W.W.M.

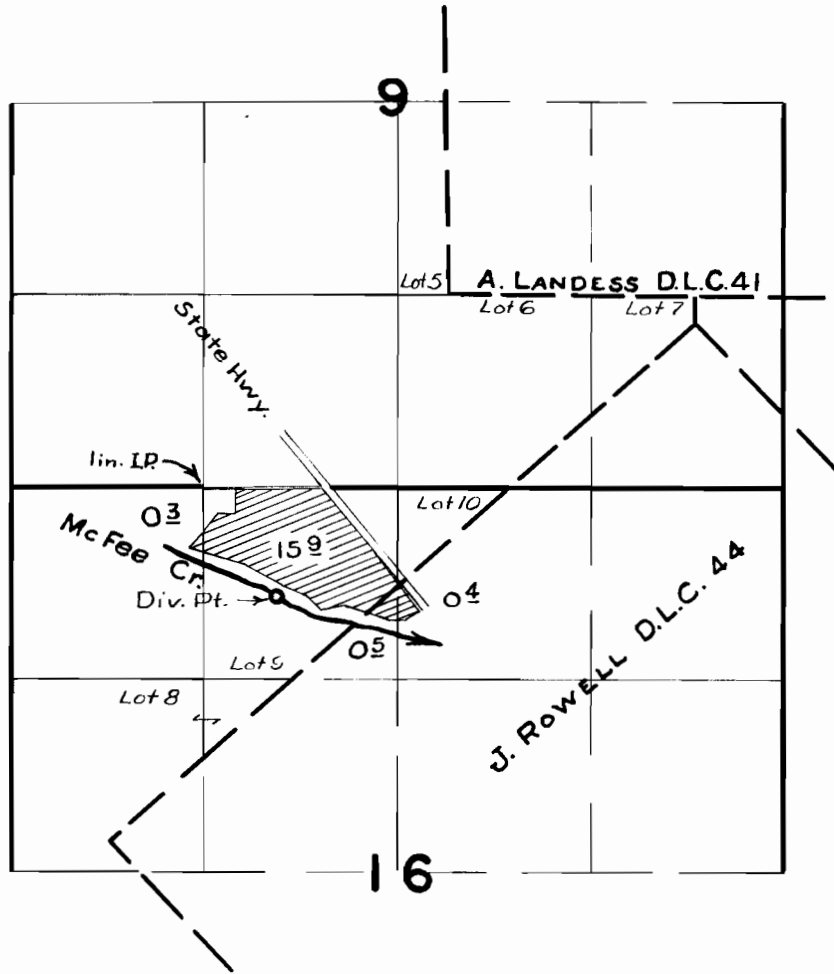

FINAL PROOF SURVEY
UNDER

Application No. 30791 Permit No. 25136
IN NAME OF

STANLEY GUILD

Surveyed 20 Aug. 1962, by M. Bish