


T.26S.,R.16E.,W.M.

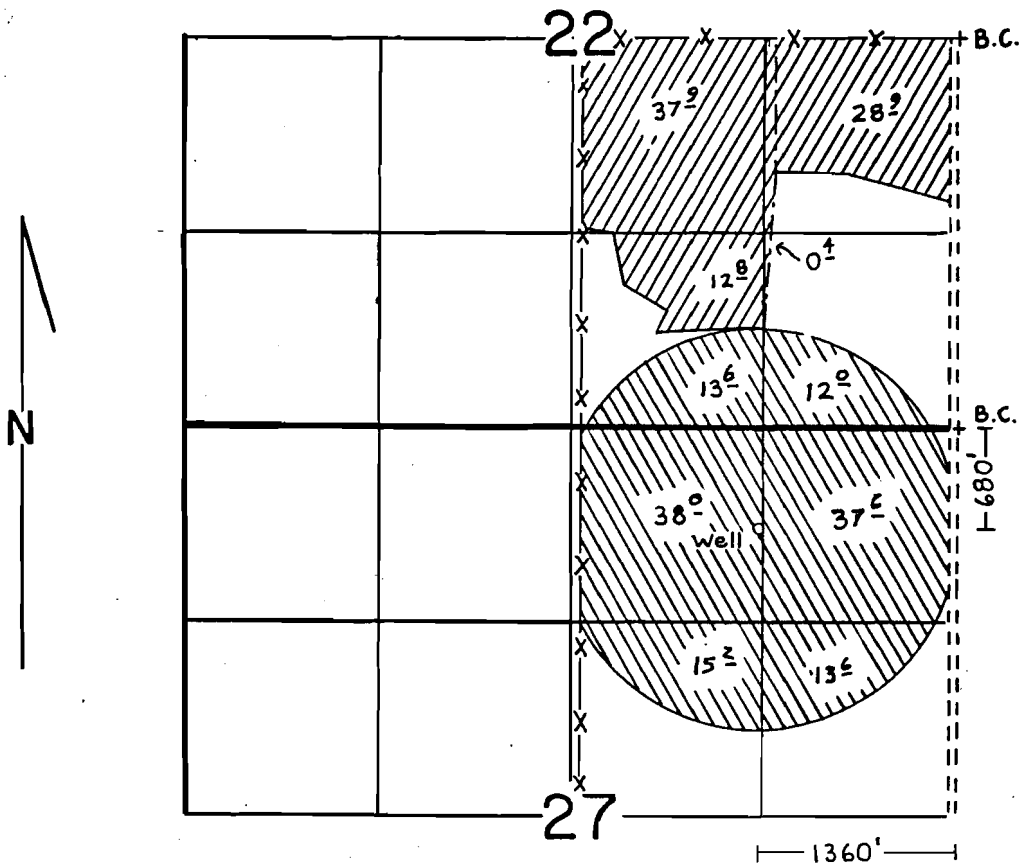

SCALE: 1" = 1320'

FINAL PROOF SURVEY
UNDER

G-7416 G-6920
Application No. G-10727. Permit No. G-9797
IN NAME OF

HAROLD WAYNE AND PATRICIA S. STUTZMAN

Surveyed MAY 15, 1985, by LESLIE OLSON