


# LAFFOLLETTE & ALLEN DITCH

T 6656  
2428  
76674

## CROOK CO.

5712  
3517

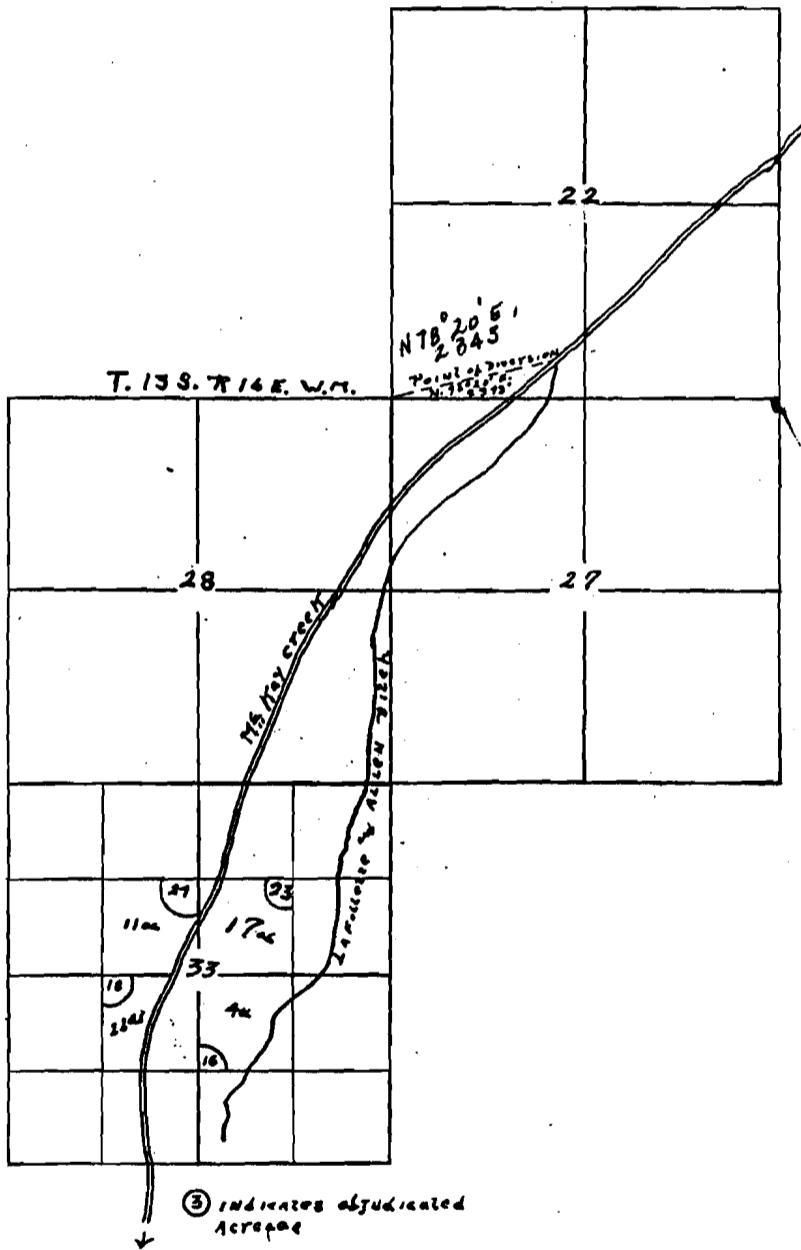

2114

5  
1  
2