


SECTION 22

THIS MAP IS FOR THE PURPOSE OF LOCATING THE WATER RIGHT ONLY AND IS NOT INTENDED TO PROVIDE LEGAL DIMENSIONS OR LOCATIONS OF PROPERTY OWNERSHIP LINES.

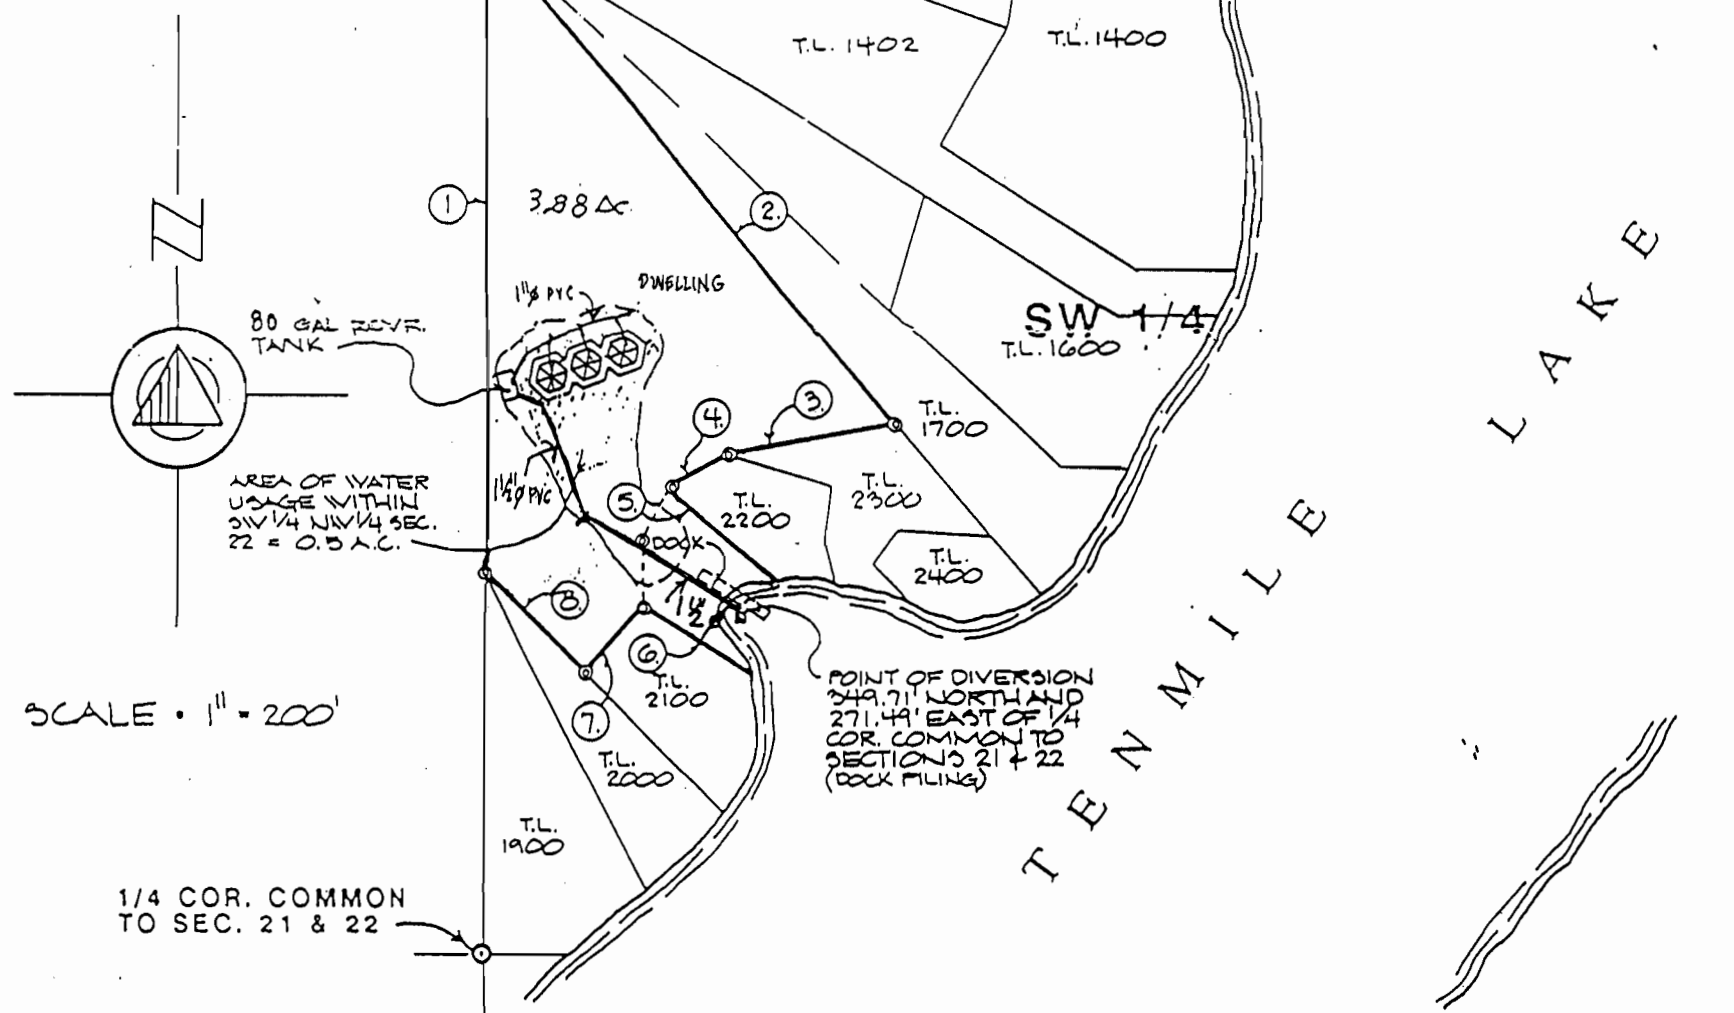

 Certified Water Right Examiner
 #112 WRE
 Edward W. Riley
 Nov. 19, 1987
 STATE OF OREGON
 12-31-2000