


Exhibit A

EXHIBIT A, HE 257
N 1/16 CERTIFICATE 76686

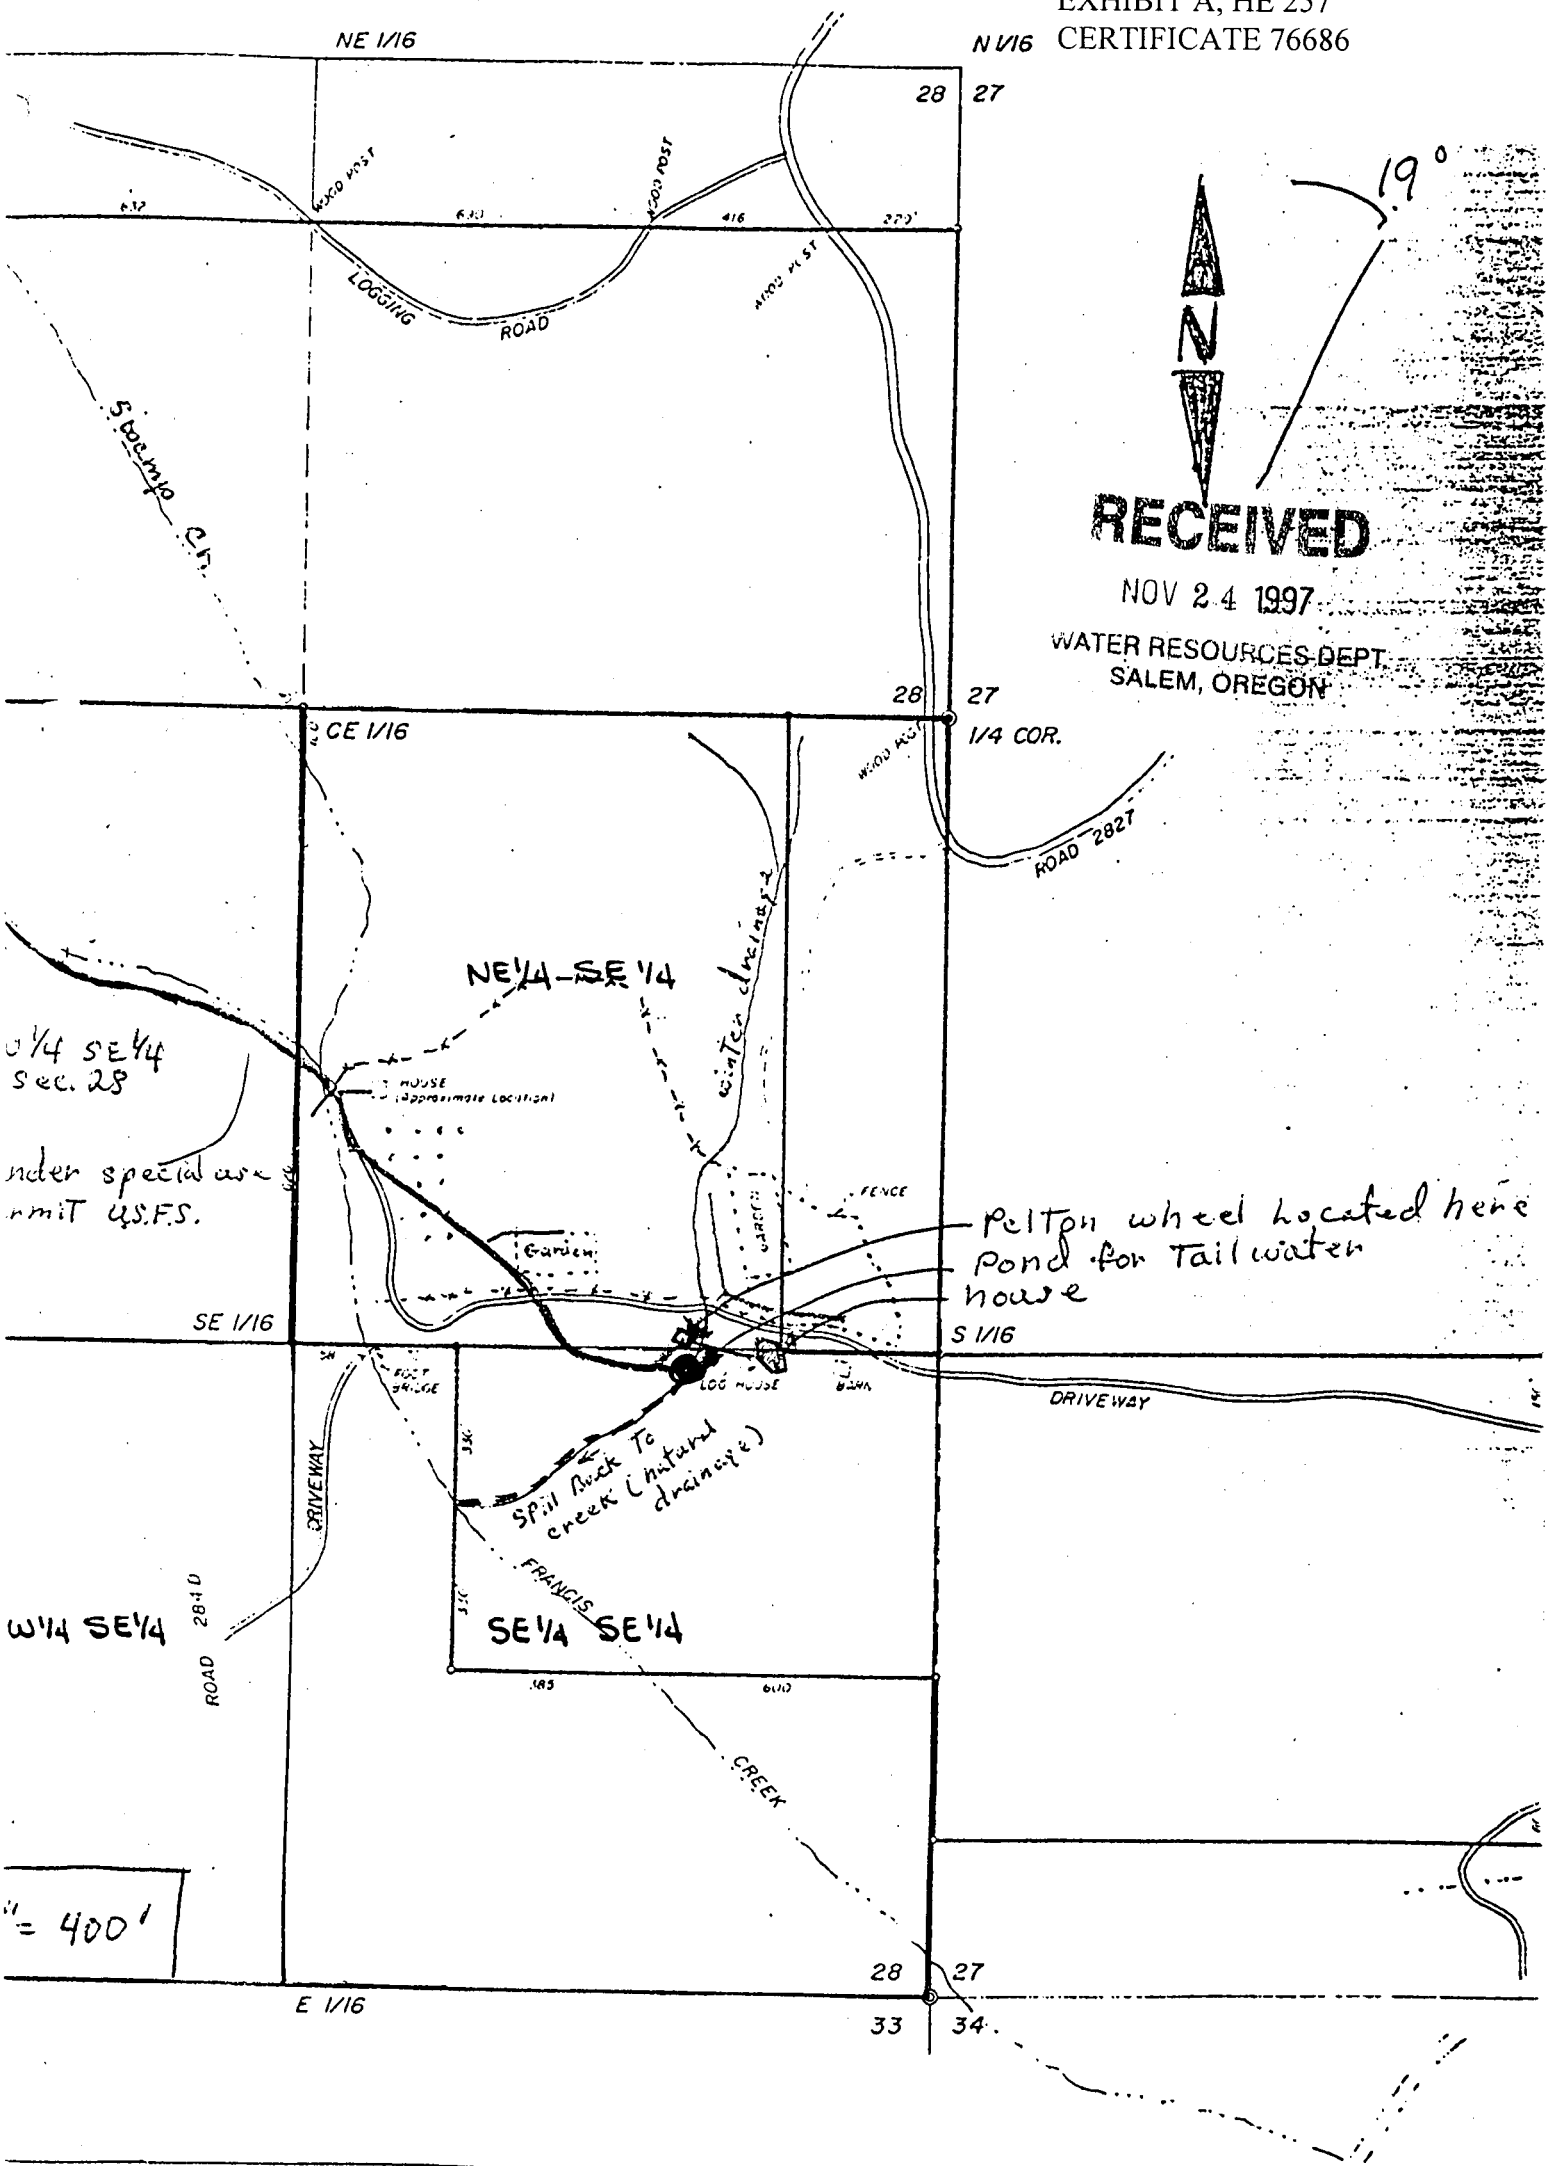

- 3" PVC water main line totaling 1800 ft. to pond
- ... orchard
- acres to be irrigated 7.5
- Pond
- 5 kw gen 12" Peltan wheel 4/5 ft/sec