RECEIVED
DEC 31 1997
WATER RESOURCES DEPT.
SALEM, OREGON

NORTH ↑

SECTION 6 T3S R2W W.M.
YAMHILL COUNTY

1" = 400'

HE249

SEE MAP
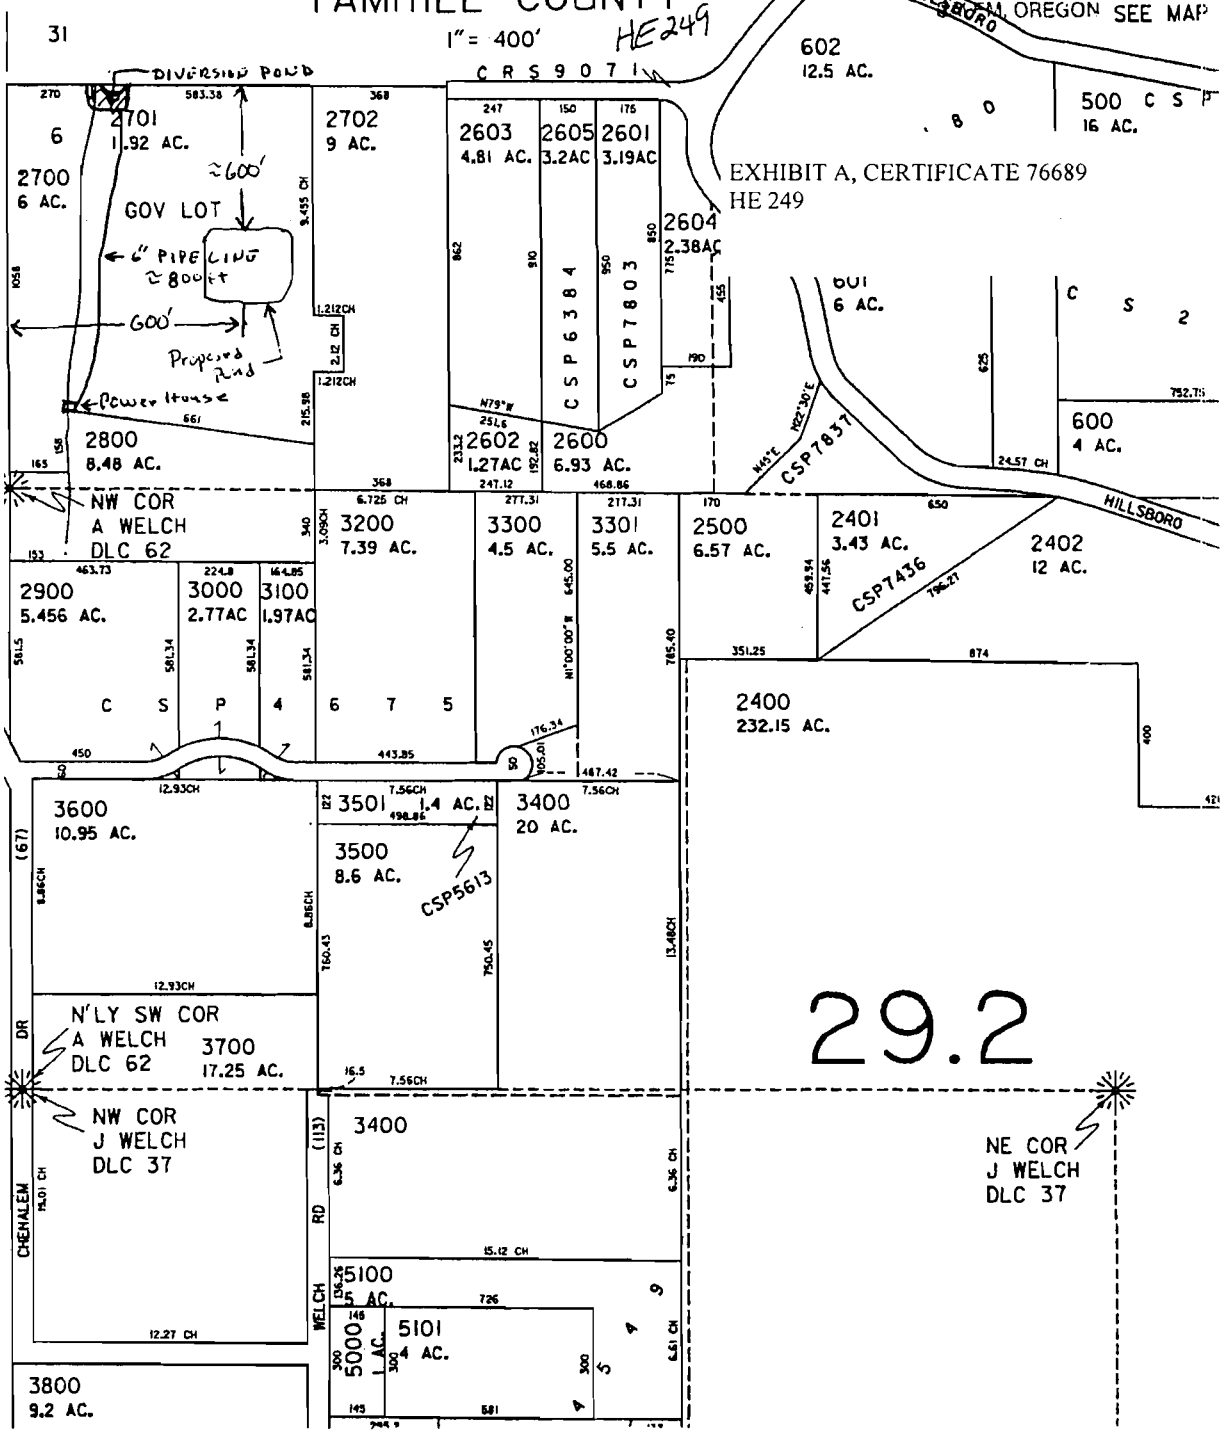
EXHIBIT A, CERTIFICATE 76689
HE 249