



RECEIVED

AUG - 7 1997

WATER RESOURCES DEPT.
SALEM, OREGON

T3S, R9W, W.M.
SECTIONS 27 AND 28

TILLAMOOK COUNTY
JAN. 24, 1997

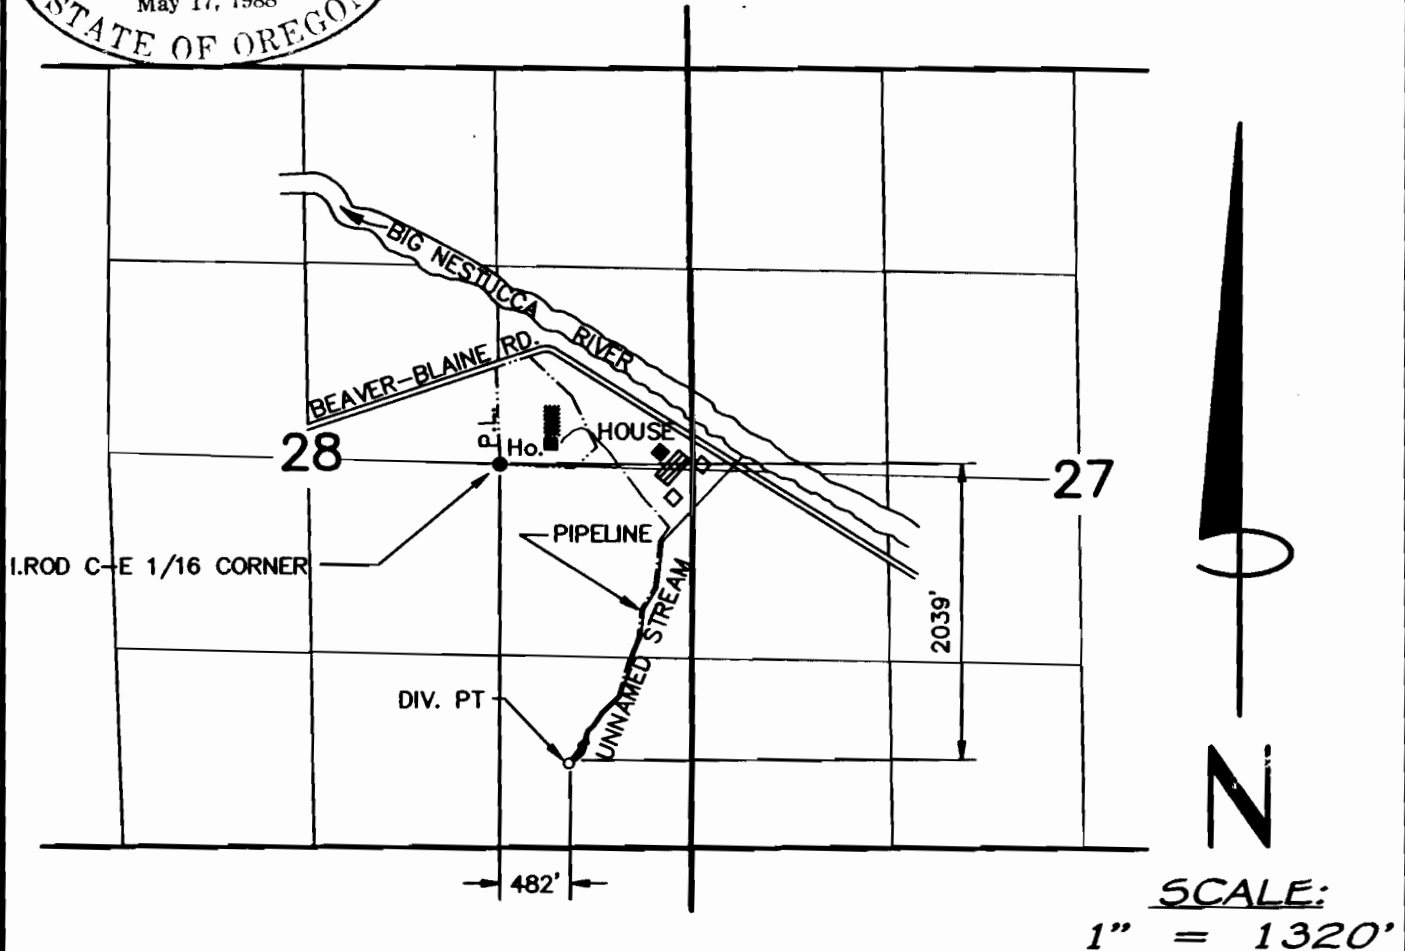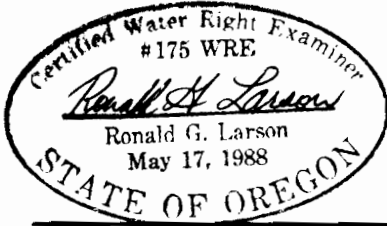

FINAL PROOF SURVEY

APPLICATION NO. 73736 PERMIT NO. 52489

IN THE NAME OF:

JENS AND PATTY SORENSEN
& DORIS ANN SORENSEN

FILE: SORENWR1.DWG

THE PURPOSE OF THIS MAP IS TO IDENTIFY THE LOCATION OF THE WATER RIGHT. IT IS NOT INTENDED TO PROVIDE INFORMATION RELATIVE TO THE LOCATION OF PROPERTY OWNERSHIP BOUNDARY LINES.

HLB & ASSOCIATES, INC.
P.O. BOX 219
MANZANITA, OR 97130
(503) 368-5394 FAX (503) 368-5847