


G 5497
T 8381
52629
76572
T 8381
76694
T 8381

T.28S.,R.16E.,W.M.

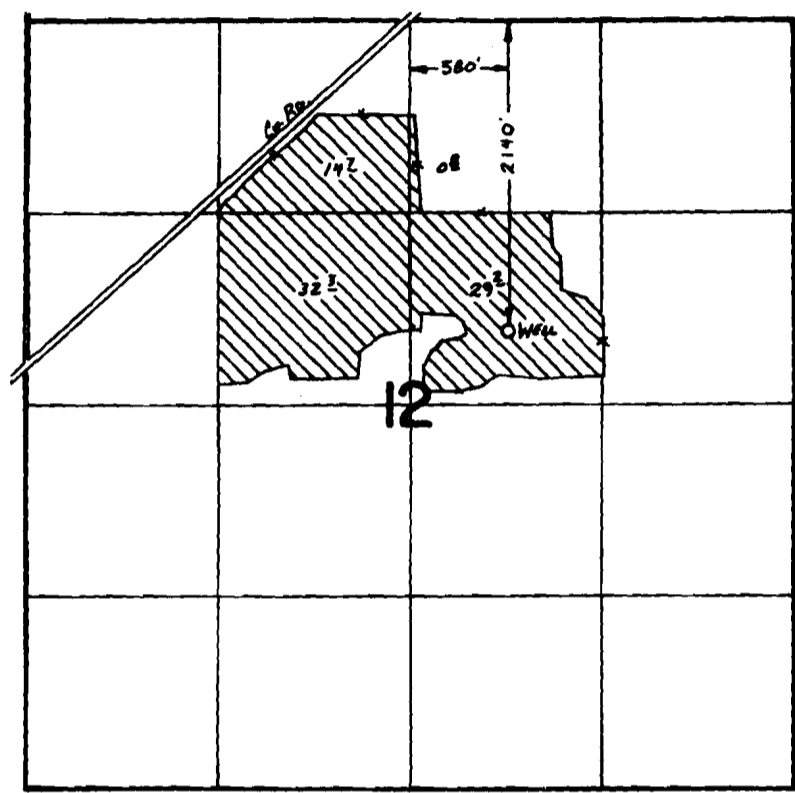

FINAL PROOF SURVEY
UNDER

Application No. G-5677. Permit No. G-5497.....
IN NAME OF

WAYNE W. HOLLINGSWORTH

Surveyed Oct. 12, 1983, by L. M. IOLL.....