


# T. 31 & 32 S. R. 3 W. W. M.

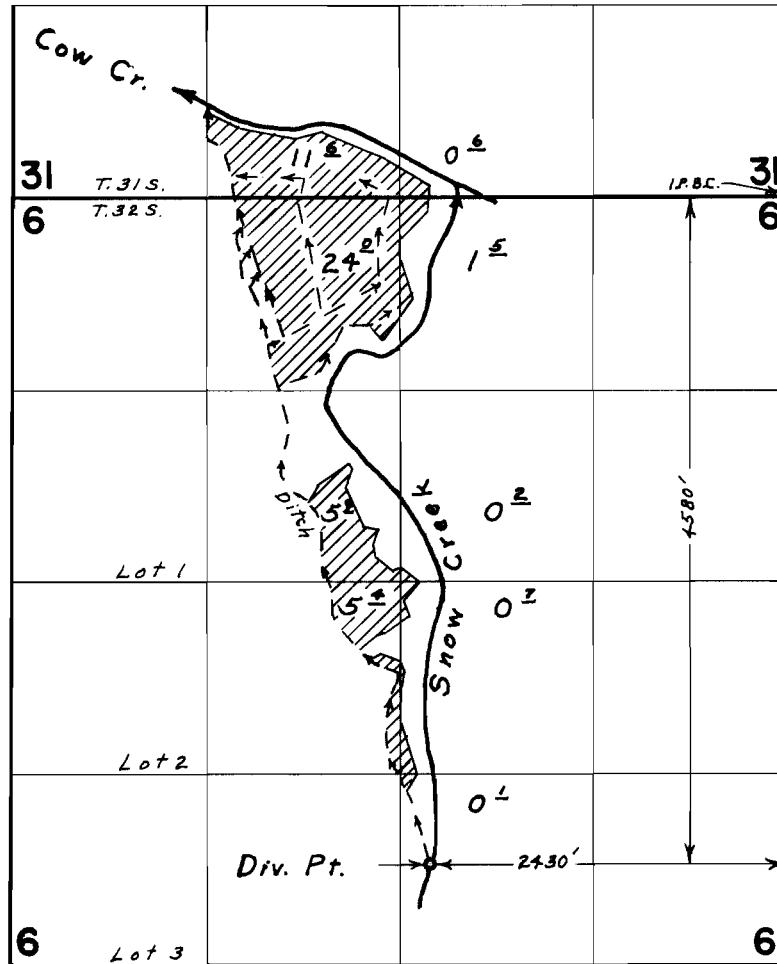

## FINAL PROOF SURVEY UNDER

Application No. 32701... Permit No. 25833...  
IN NAME OF  
**HERBERT JONES JR.**

Surveyed April 29, 1969, by L. E. Gould