


Jenny Creek

-MAP-  
Accompanying Final Proof of Louis Miller of Jackson County  
Post Office: Capco Calif. of Permit No. 7559 to the Waters of  
Jenny Creek tributary to Klamath River for Irrigation of Land  
in Jackson County Oregon

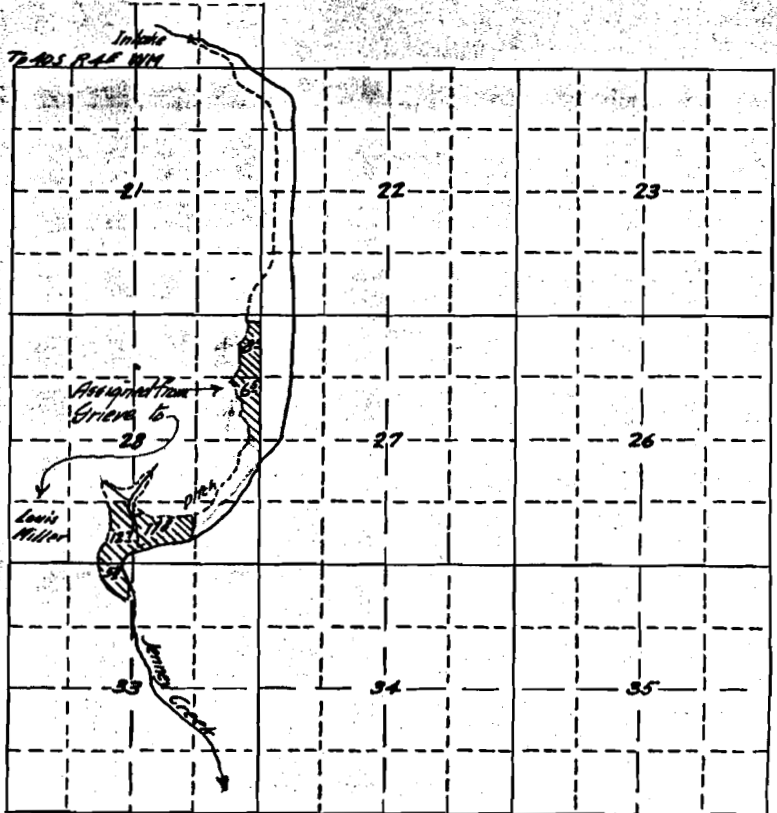

Map made from Plane table Survey Made by Chester A. Cummings

App 11081  
Chester A. Cummings Per 7559