


T. 9 S. R. 2 W. W. M.

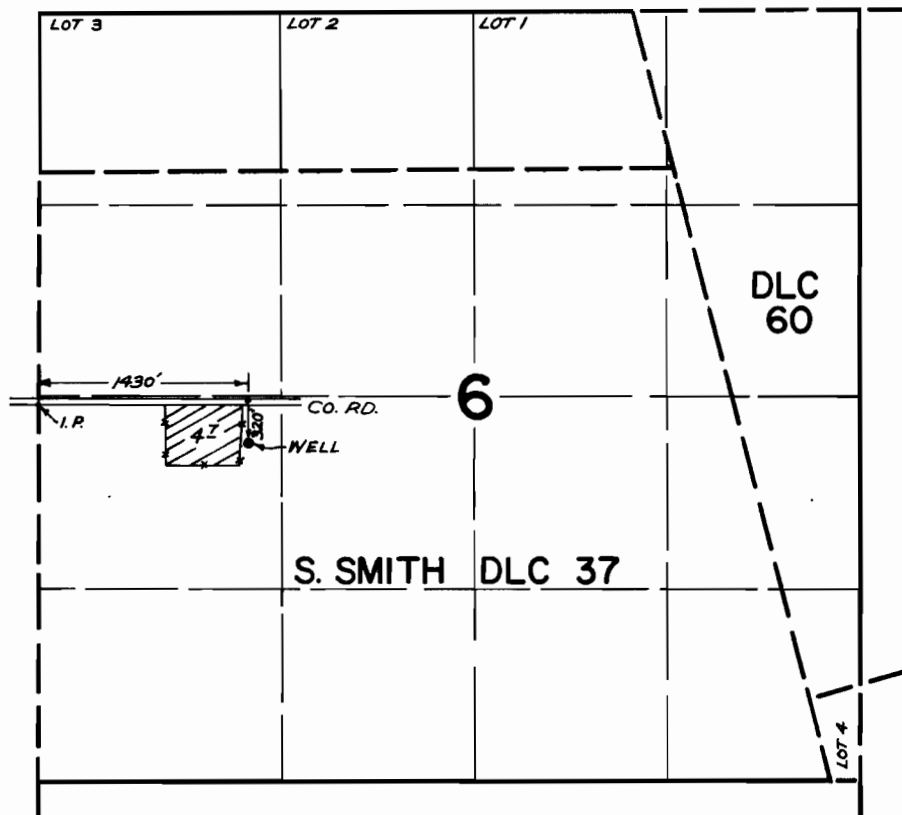

FINAL PROOF SURVEY
UNDER

Application No. G-3227 Permit No. G-3035
IN NAME OF

DERAL & NELLDA JONES

Surveyed APR 30 1971, by GREG BACA