


P.O.D. NO.2  
BOEING PUMPS LOCATED 1710 FT NORTH , 1970 FT WEST  
FROM THE SOUTHEAST CORNER SECTION 36. TAGGARES  
PUMPS LOCATED 1730 FT NORTH AND 2140 FT WEST FROM  
THE SOUTHEAST CORNER SECTION 36

BACKWATER OF JOHN DAY RESERVOIR

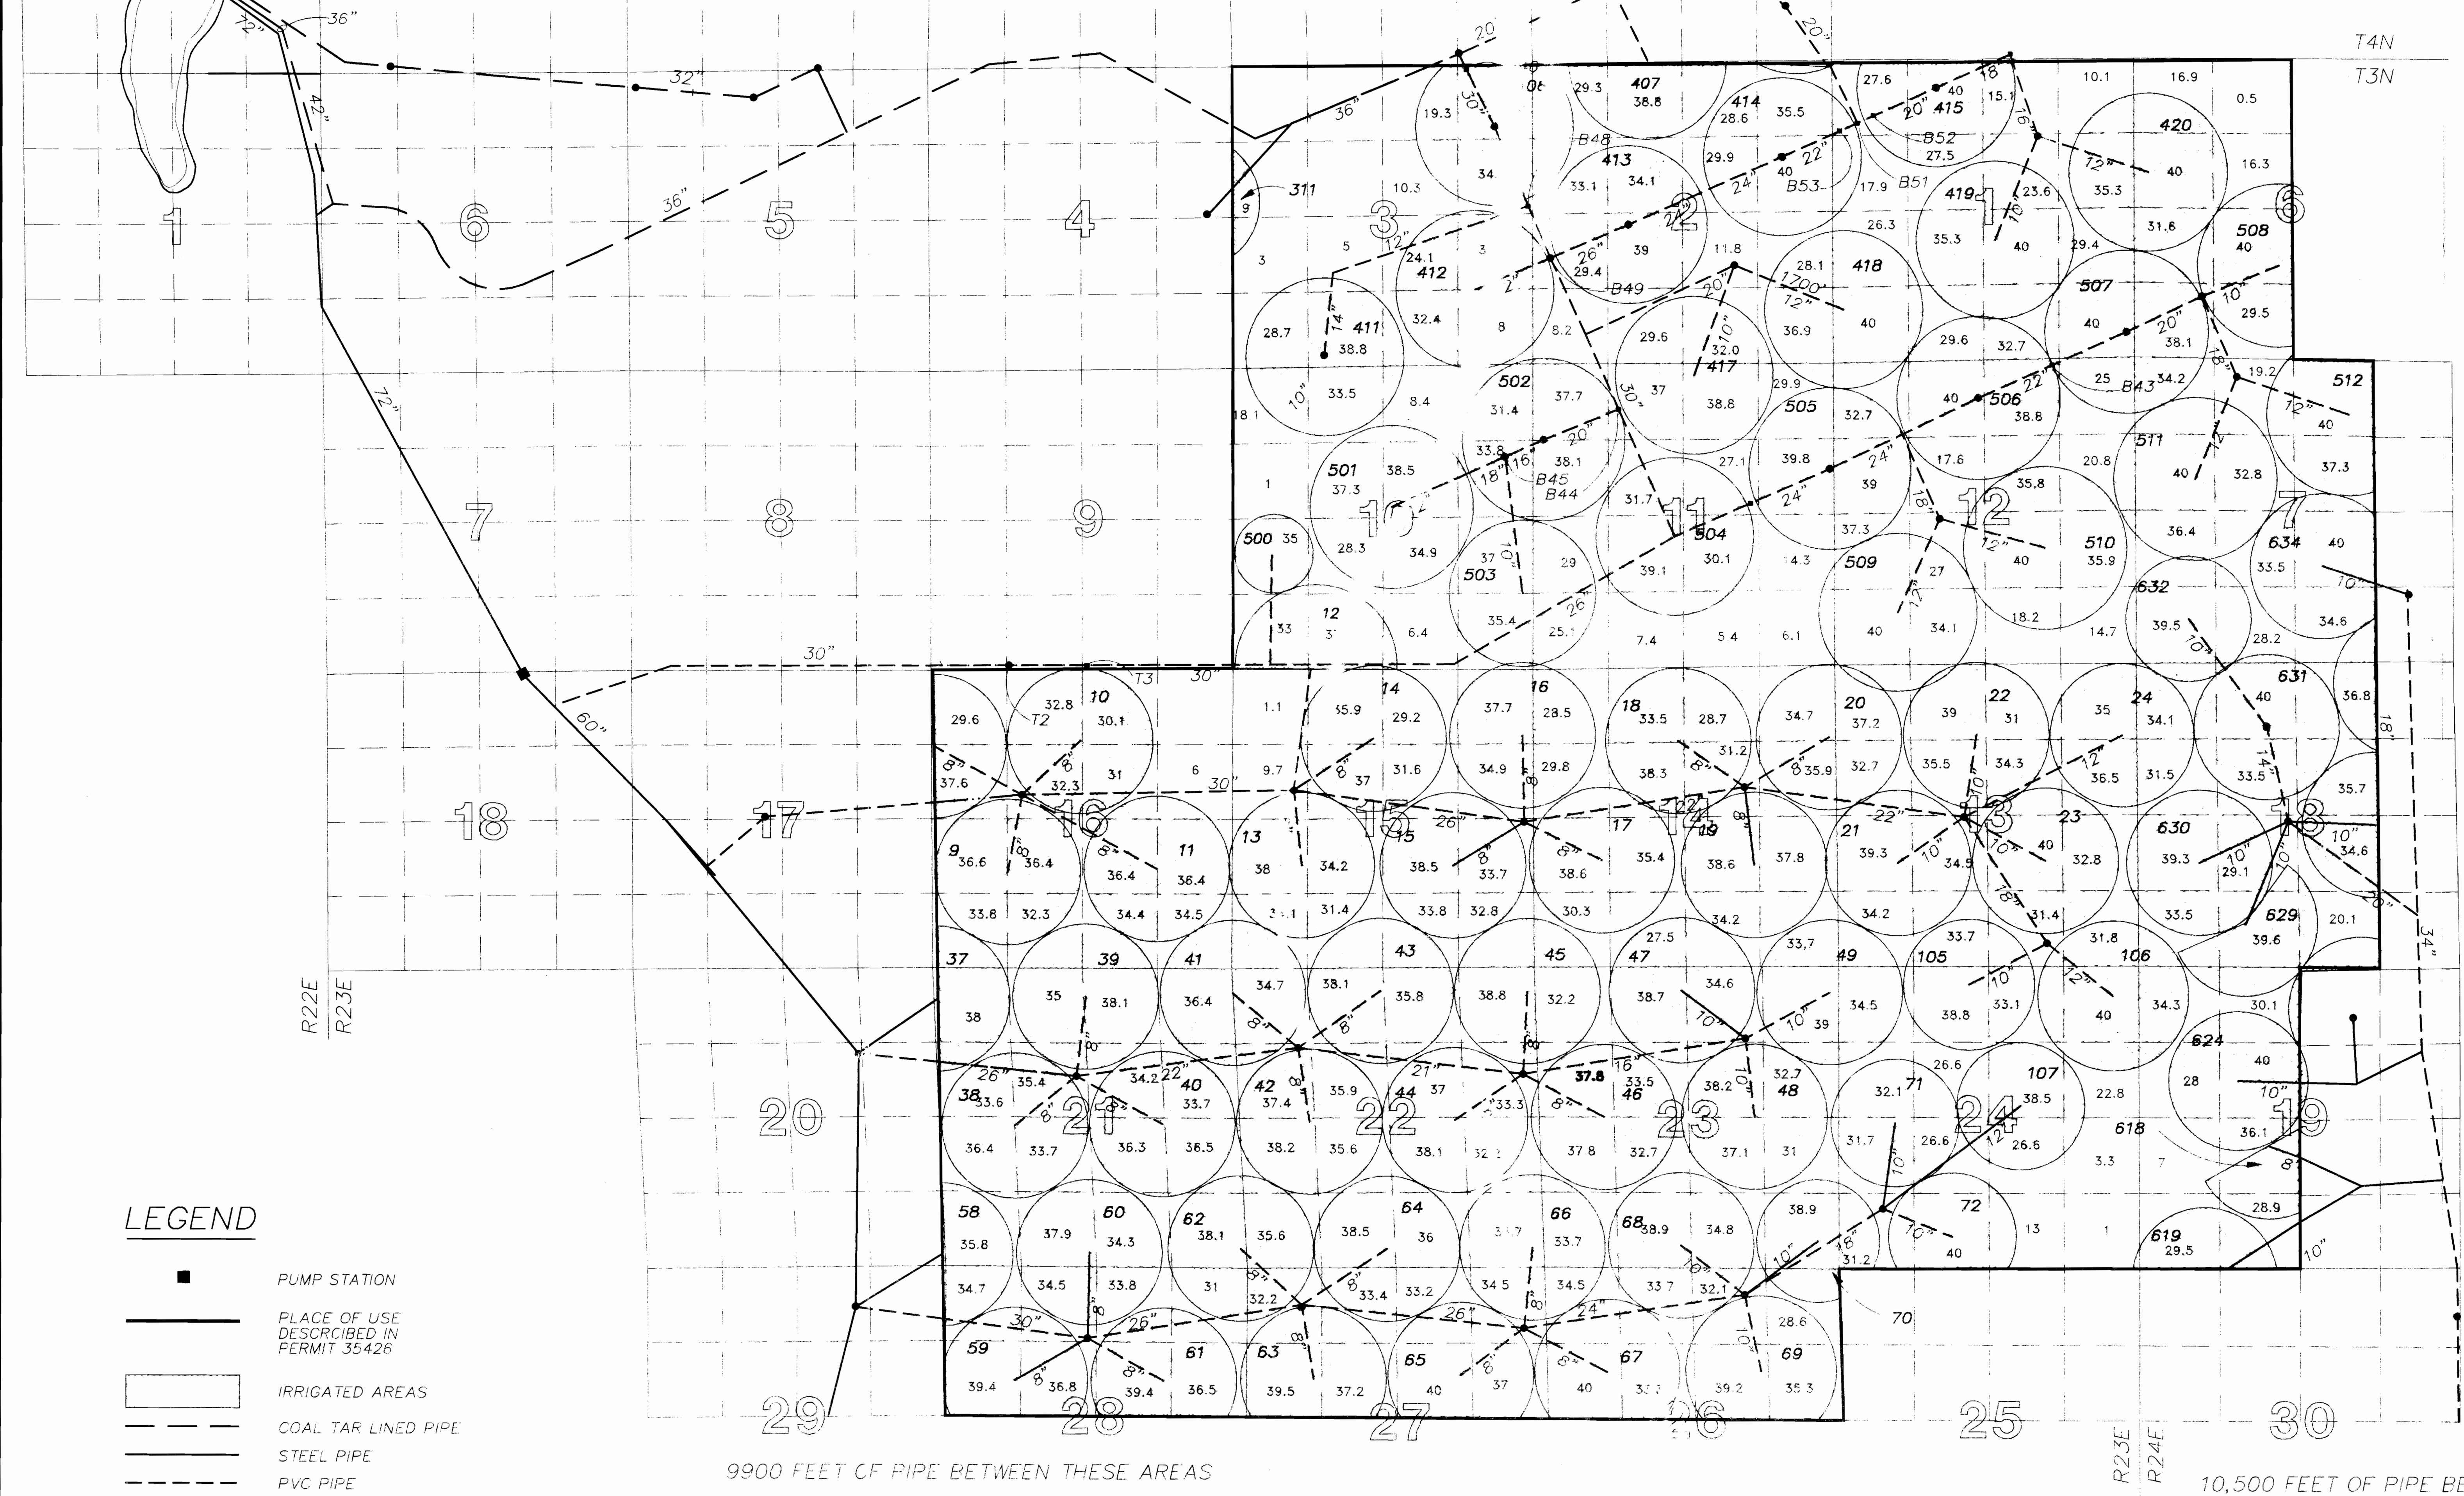


SCALE: 1"=1320'

LOCATION OF PIVOT PADS (CENTER OF CIRCLES)

PIVOT#	TOWNSHIP	RANGE
1	33N	R23E
2	33N	R23E
**LEGEND**

- PUMP STATION
  - PLACE OF USE DESCRIBED IN PERMIT 35426
  - ▭ IRRIGATED AREAS
  - COAL TAR LINED PIPE
  - STEEL PIPE
  - PVC PIPE
  - CEMENT MORTAR LINED PIPE
  - 8 SECTION NUMBER
  - 40 NUMBER OF ACRES IRRIGATED IN THE 1/4 1/4 SECTION
- ALL LOCATIONS ARE REFERENCED FROM THE WILLAMETTE MERIDIAN

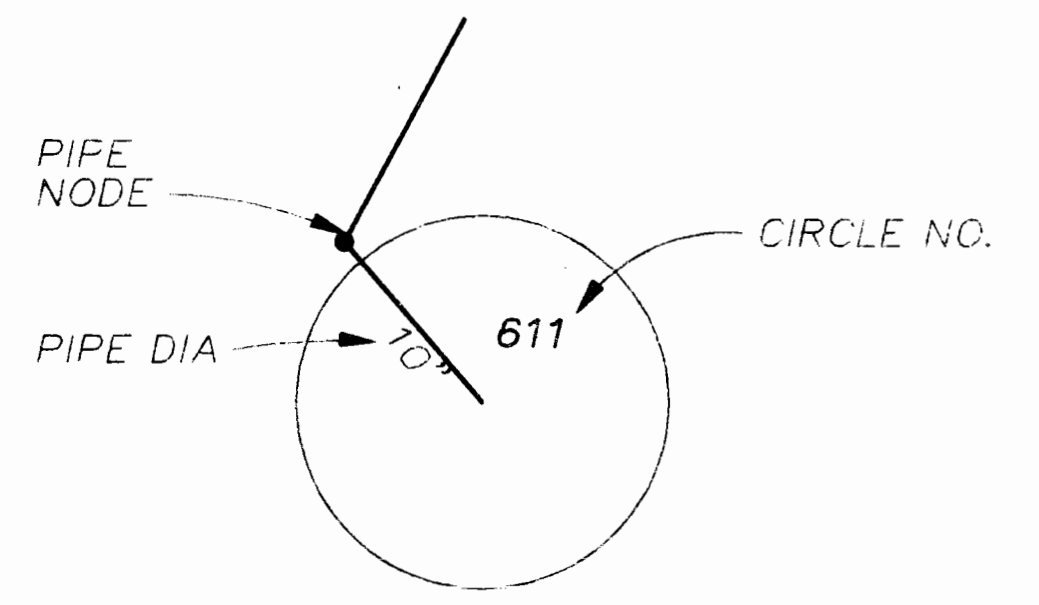

9900 FEET OF PIPE BETWEEN THESE AREAS

10,500 FEET OF PIPE BETWEEN THESE AREAS

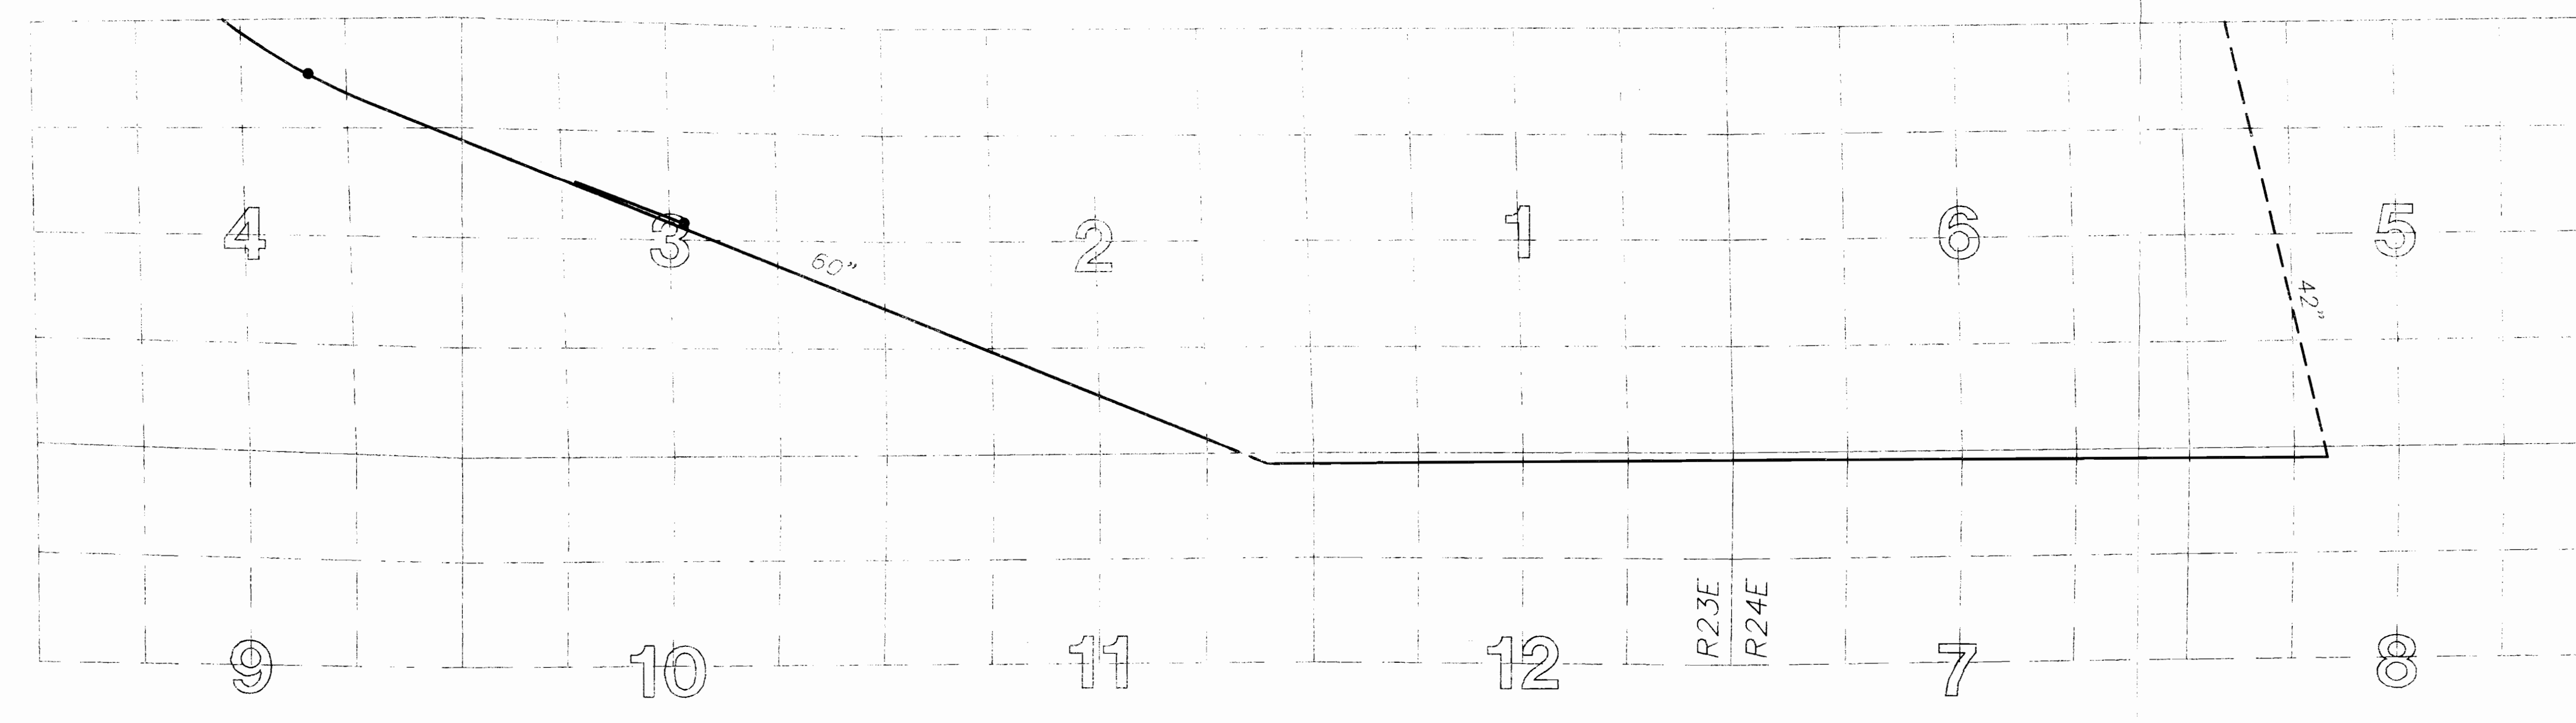

DR	M.F. MADISON
CHK	S.R. BAILEY
APPROV	D. COLLINS
	M.F. MADISON

**FINAL PROOF SURVEY**  
APPLICATION: 48683 PERMIT: 35426

THE PURPOSE OF THIS MAP IS TO IDENTIFY THE LOCATION OF THE WATER RIGHT. IT IS NOT INTENDED TO PROVIDE INFORMATION RELATIVE TO THE LOCATION OF PROPERTY OWNERSHIP BOUNDARY LINES.

**VERIFY SCALES**  
BAR IS ONE INCH ON ORIGINAL DRAWING  
IF NOT ONE INCH ON THIS SHEET, ADJUST SCALES ACCORDINGLY

BOEING AGR-INDUSTRIAL COMPANY PO BOX 139 BOARDMAN, OREGON	SHEET DWG NO DATE DEC 1993 PROJ NO PDX36494.A0
---	---