


T. 3N. R. 27E. W.M.

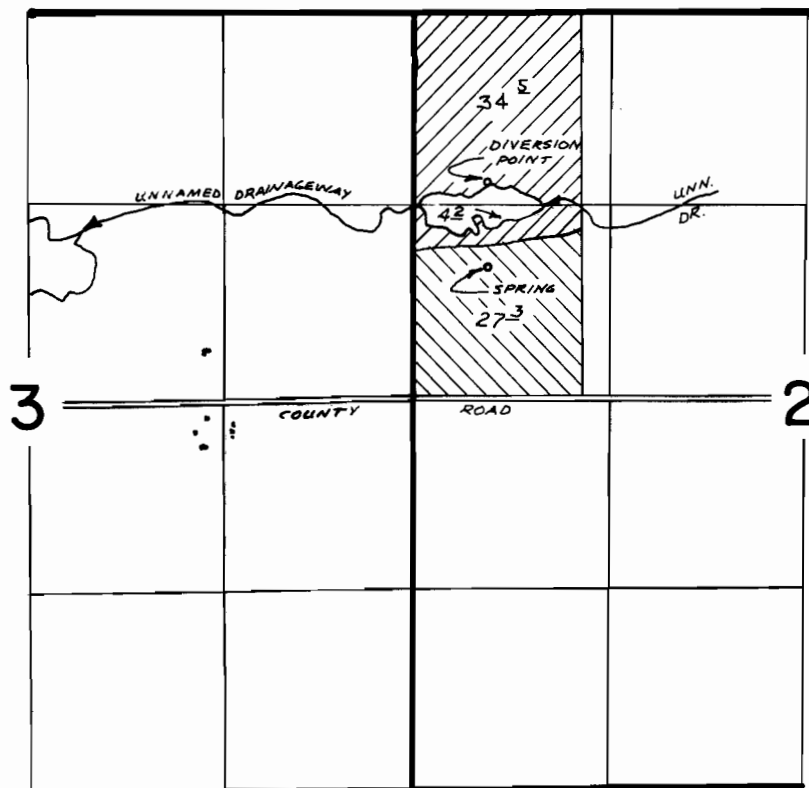

DIVERSION POINT LOCATED 1170'S. & 490'E. FROM NW COR SEC 2
SPRING LOCATED 1750'S. & 500'E. FROM NW COR SEC 2



PRIMARY



SUPPLEMENTAL

FINAL PROOF SURVEY UNDER

Application No. 51820 Permit No. 37296

IN NAME OF

TYLER & FRANCES HANSELL

Surveyed DEC. 8. 1977, by R. BARWIN