


T. 3N., R. 28E., W.M.

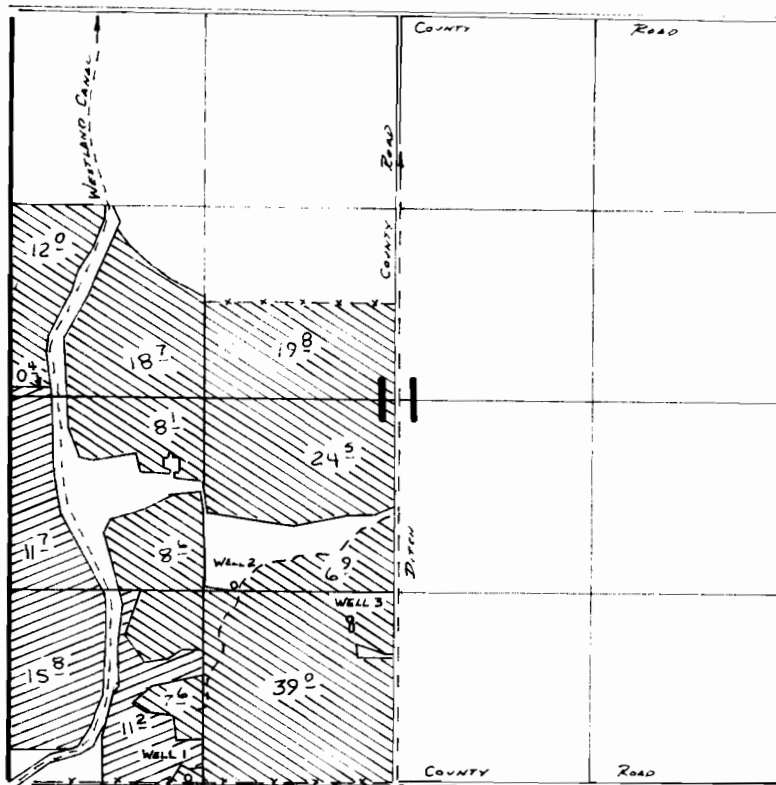

SCALE: 1" = 1320'

WELL 1 LOCATED 40' N. & 1230' E FROM SW CORNER SECTION 11
 WELL 2 LOCATED 1360' N. & 1540' E. FROM SW CORNER SECTION 11



PRIMARY



SUPPLEMENTAL

FINAL PROOF SURVEY
 UNDER

Application No. **G:6429** Permit No. **G:6038**...
 IN NAME OF

EMERT RANCHES

Surveyed 2.14..... 19.72., by R. Brown