


# T.4N. R.27&28 E.W.M.

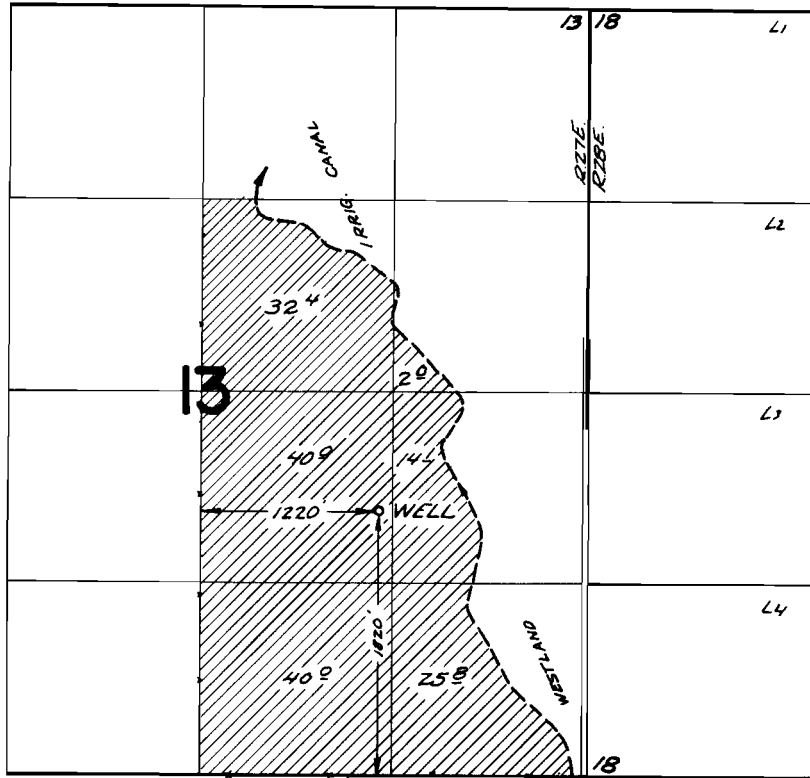

## FINAL PROOF SURVEY UNDER

Application No. G-2809 Permit No. G-2620  
IN NAME OF

FLOYD A. OMAN

Surveyed June 22 1967, by L. E. Sevid