


T.3N.R.28E.W.M.

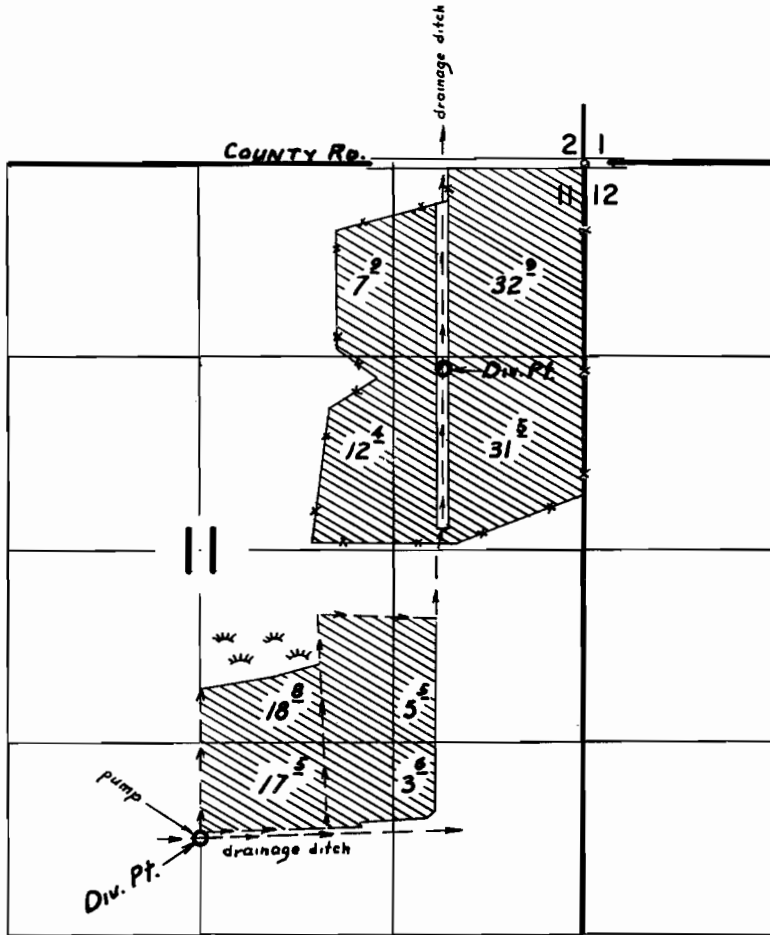

Div. Pts. located: 1410 ft. S. & 970 ft. W.; and 4610 ft. S. & 2630 ft. W.; both from NE. cor. Sec. 11

FINAL PROOF SURVEY UNDER

Application No. 37613 38765 Permit No. 28053 28936
IN NAME OF

JOHN M. CORREA

Surveyed Jul. 10 1969, by L. E. Gould