


# T.38&4N.R.27E.W.M.

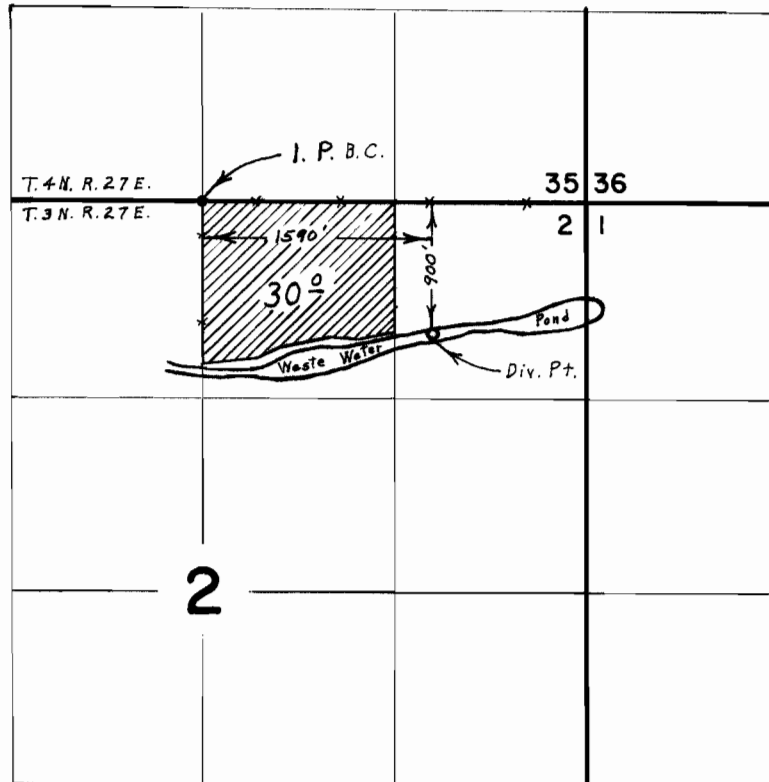

## FINAL PROOF SURVEY UNDER

Application No. 38120 Permit No. 28411  
IN NAME OF

LARRY E. KASEBERG & RICHARD L. SKILES

Surveyed Aug. 6, 1966, by L. E. Gould