


T.3 N. R.27 E. W.M.

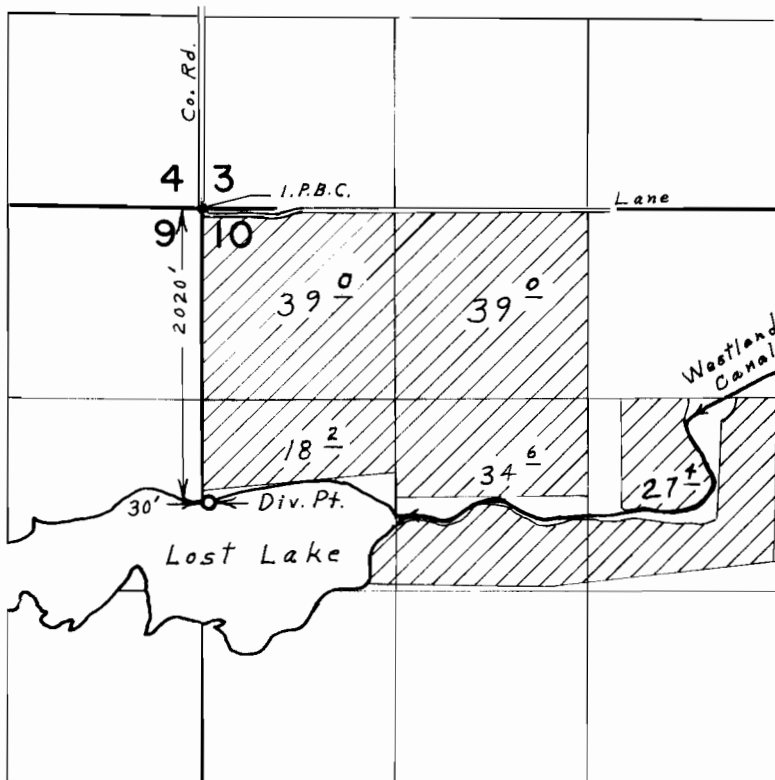

**FINAL PROOF SURVEY**  
UNDER

Application No. 41885 Permit No. 31351  
IN NAME OF

ALFRED ANDERSEN

Surveyed April 16, 1973, by L. E. Gould.