


T. 4 N. R. 28 E. W. M.

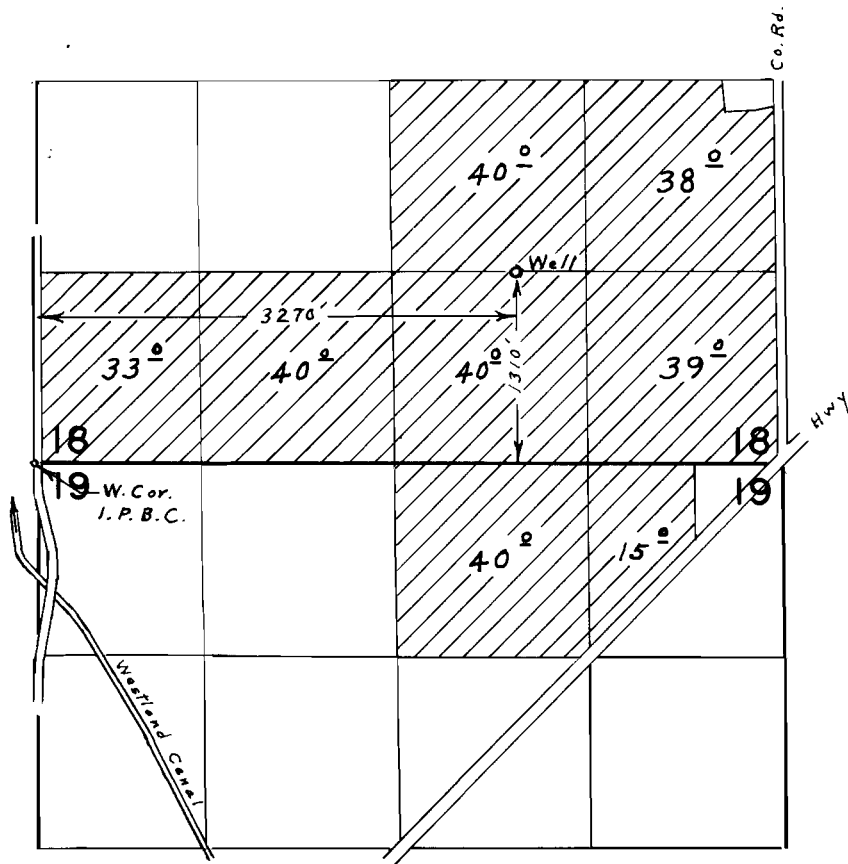

FINAL PROOF SURVEY UNDER

Application No. G-4103 Permit No. G-3851
IN NAME OF

WOODROW WALKER

Surveyed June 24, 1971, by L. E. Gould