


T. 4 N. R. 27 & 28 E. W. M.

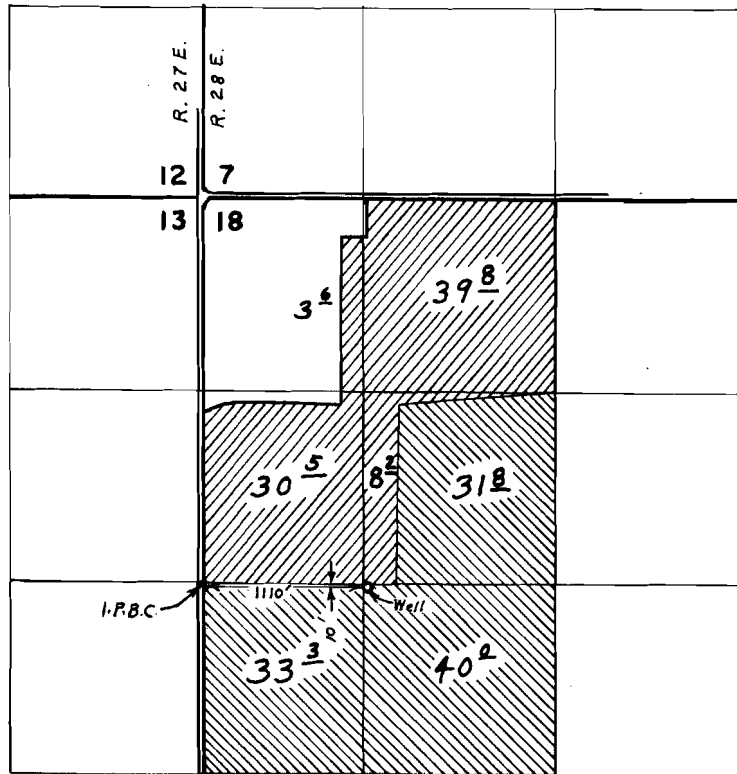

Primary 
 Supplemental 

FINAL PROOF SURVEY UNDER

Application No. G-2768 Permit No. G-2592

IN NAME OF

THOMAS E. HUDDLESTON

Surveyed August 8, 1966, by L. E. Gould