


Section 1, Township 38 South, Range 5 West, W.M.

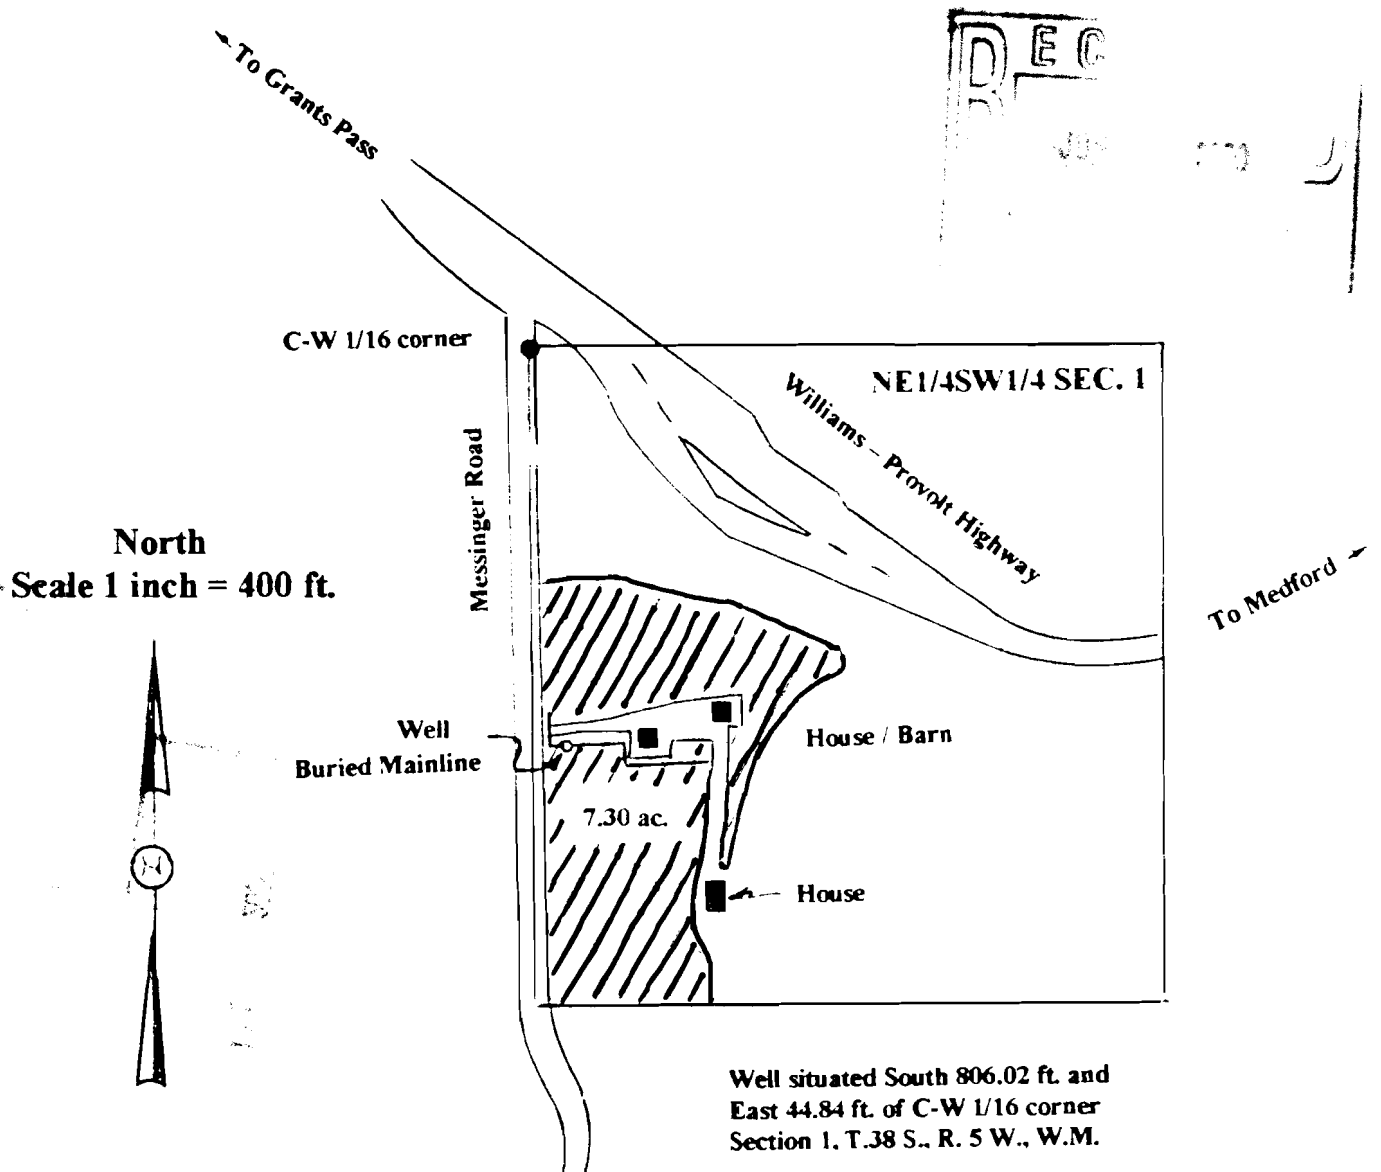

Well situated South 806.02 ft. and East 44.84 ft. of C-W 1/16 corner Section 1, T.38 S., R. 5 W., W.M.

**FINAL PROOF SURVEY
UNDER**

Application No. G-14590, Permit No. G-13422

THIS MAP WAS PREPARED FOR THE PURPOSE OF IDENTIFYING THE LOCATION OF A WATER RIGHT ONLY AND IS NOT INTENDED TO PROVIDE LEGAL DIMENSIONS OR LOCATION OF PROPERTY OWNERSHIP LINES.

