

RECEIVED


MAR 18 1998

WATER RESOURCES DEPT.
SALEM, OREGON

T. 36S., R. 4 W., W. M.




SCALE: 1" = 400'

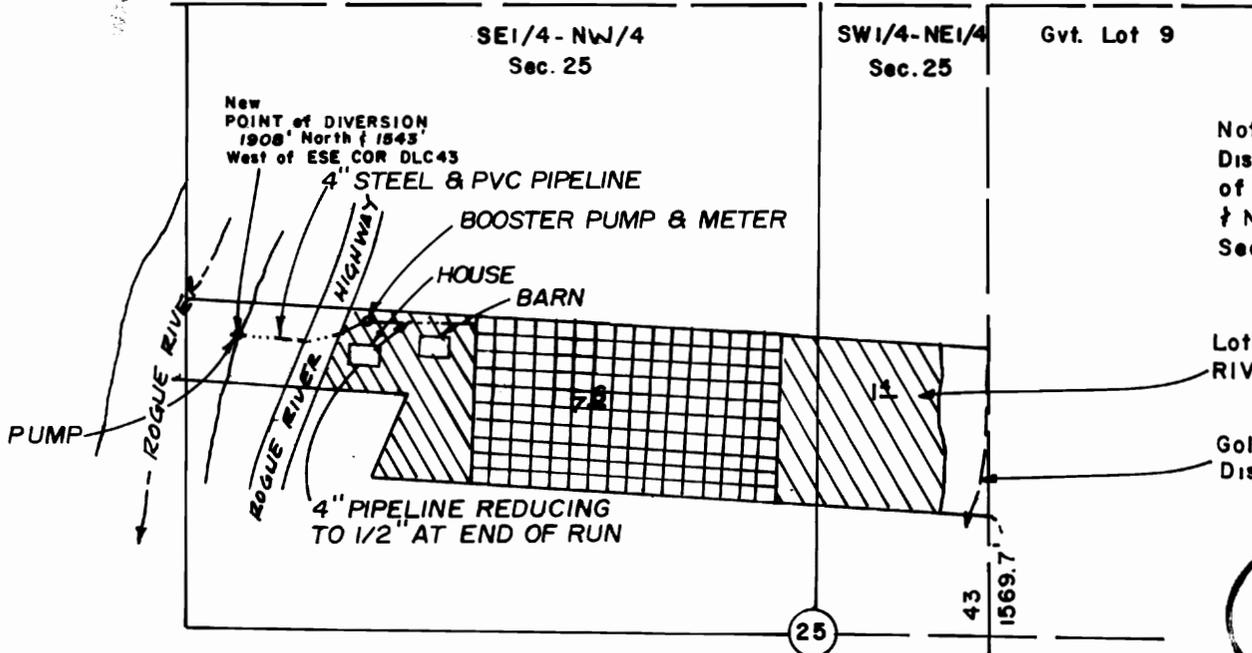

Note: The Gold Hill Irrigation District's Point of Diversion out of Rogue River bears East, 2260' North, 3740' from the SW. Cor. Sec. 11, T.36S., R.3W., W.M.

Lot 17 Amended Plat of RIVERSIDE SUBDIVISIONS

Gold Hill Irrigation District Ditch

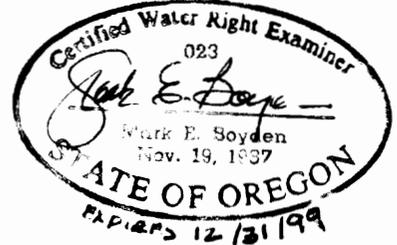

Application No. T-7529

Permit No. _____

■■■■■ - IRRIGATED BERRY PLANTATION

////// - IRRIGATED PASTURE AREA

DATE OF COMPLETED SURVEY

2 / 4 / 98

Applicant

Jerry A. & Patricia R. Smith
2183 Rogue River Highway
Gold Hill, Oregon 97525

NOTE: THIS MAP HAS BEEN PREPARED FOR WATER RIGHT PURPOSES ONLY, NOT FOR PROPERTY BOUNDARY LOCATIONS