


FINAL PROOF SURVEY MAP
 IN THE NAME OF RICHARD HALLIBURTON
 SECTION 3, T 28 S, R 14 W, W.M.

RECEIVED
 JUL 19 1996
 WATER RESOURCES DEPT.
 SALEM, OREGON

APPLICATION G-12162

PERMIT G-11388

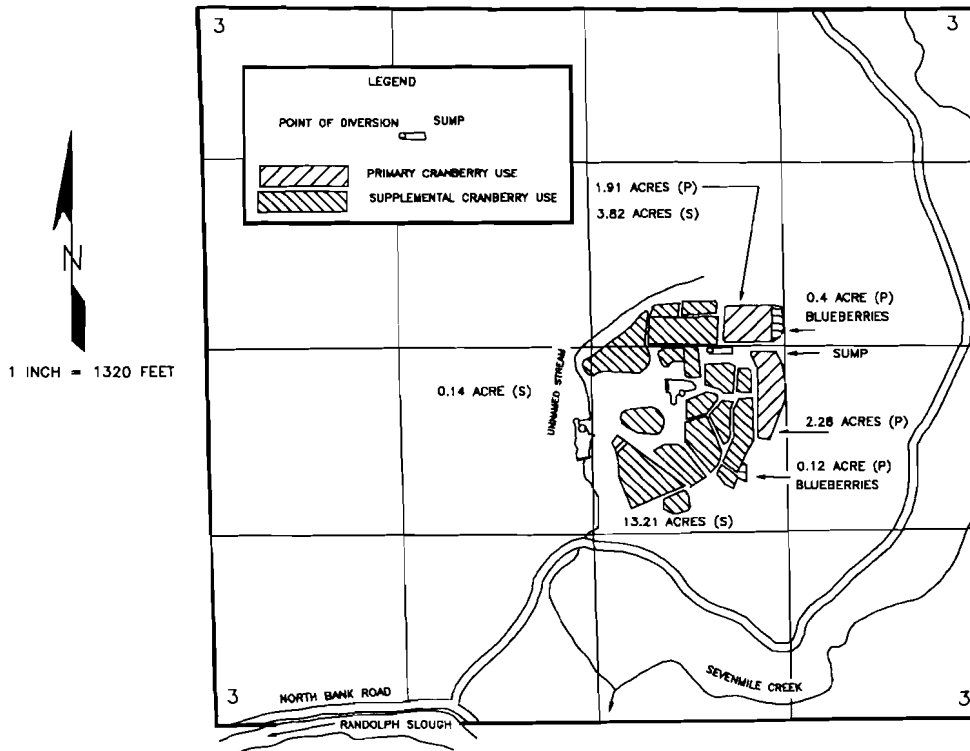

THE POINT OF DIVERSION IS LOCATED 2,365 FEET SOUTH AND 1,800 FEET WEST FROM THE NORTHEAST CORNER OF SECTION 3, BEING WITHIN THE NW¼ OF THE SE¼ OF SECTION 3, TOWNSHIP 28 SOUTH, RANGE 14 WEST, W.M., COOS COUNTY.

THE PURPOSE OF THIS MAP IS TO IDENTIFY THE LOCATION OF THE WATER RIGHT. IT IS NOT INTENDED TO PROVIDE INFORMATION RELATIVE TO THE LOCATION OF PROPERTY OWNERSHIP BOUNDARY LINES.

Certified Water Right Examiner
 #054 WRE
James F. Gosson
 James F. Gosson
 Nov. 19, 1987
 STATE OF OREGON