


FINAL PROOF SURVEY MAP
 IN THE NAME OF RICHARD HALLIBURTON

SECTION 3, T 28 S, R 14 W, W.M.

APPLICATION R-70462
 APPLICATION 70463

PERMIT R-11422
 PERMIT 51380

RECEIVED
 JUL 19 1996
 WATER RESOURCES DEPT.
 SALEM, OREGON

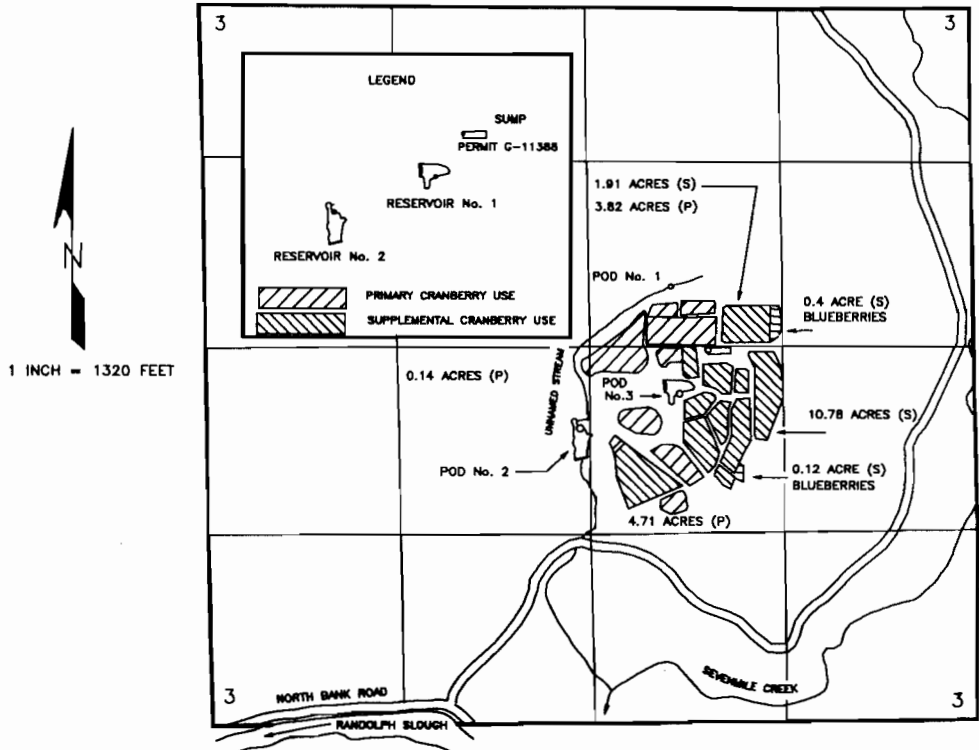

THE POINTS OF DIVERSION ARE LOCATED AS FOLLOWS:

DIVERSION	SOUTH	WEST	¼ ¼	SECTION
UNNAMED STREAM P.O.D. No. 1	2,060 FEET	1,930 FEET	SW¼NE¼	3
RESERVOIR No. 2 P.O.D. No. 2	2,900 FEET	2,680 FEET	NE¼SW¼	3
RESERVOIR No. 1 P.O.D. No. 3	2,650 FEET	1,990 FEET	NW¼NE¼ 15	3

ALL FROM THE NORTHEAST CORNER OF SECTION 3, WITHIN SECTION 3, TOWNSHIP 28 SOUTH, RANGE 14 WEST, W.M.; IN COOS COUNTY.

THE PURPOSE OF THIS MAP IS TO IDENTIFY THE LOCATION OF THE WATER RIGHT.
 IT IS NOT INTENDED TO PROVIDE INFORMATION RELATIVE TO THE LOCATION OF
 PROPERTY OWNERSHIP BOUNDARY LINES.

Certified Water Right Examiner
 #054 WRE
James F. Gosson
 James F. Gosson
 Nov. 19, 1987
 STATE OF OREGON