


T. 10 S., R. 21 & 22 E., W.M.

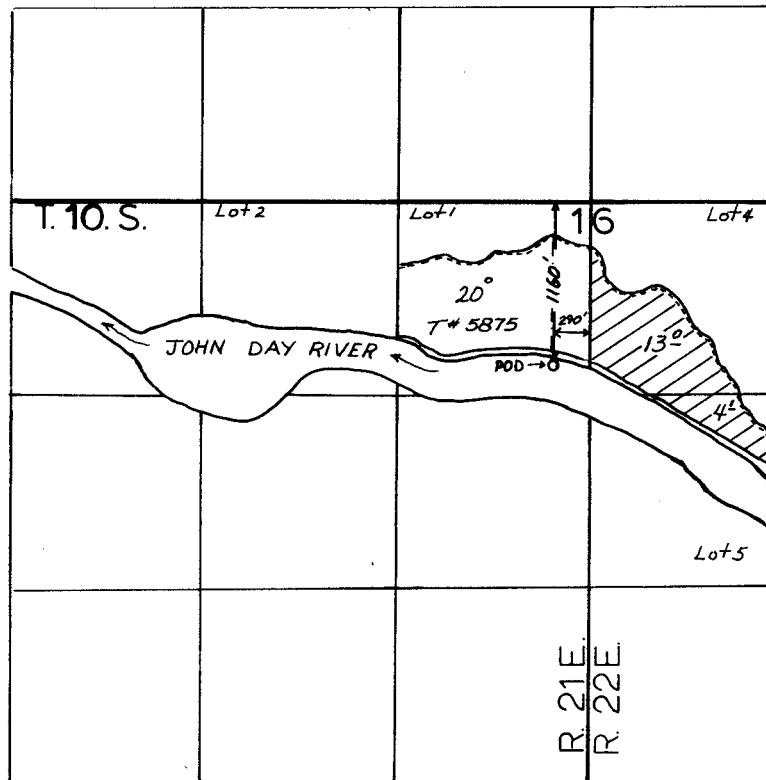

1" = 1320'

FINAL PROOF SURVEY

UNDER

Application No. 64549 Permit No. 47237
IN NAME OF

PAT BOHANNON

Surveyed 7-6, 1992, by J. MILLER