
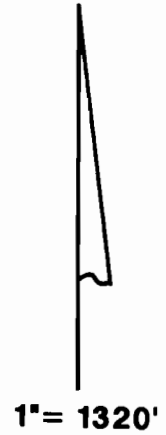


# T.6S., R.2W., W.M.

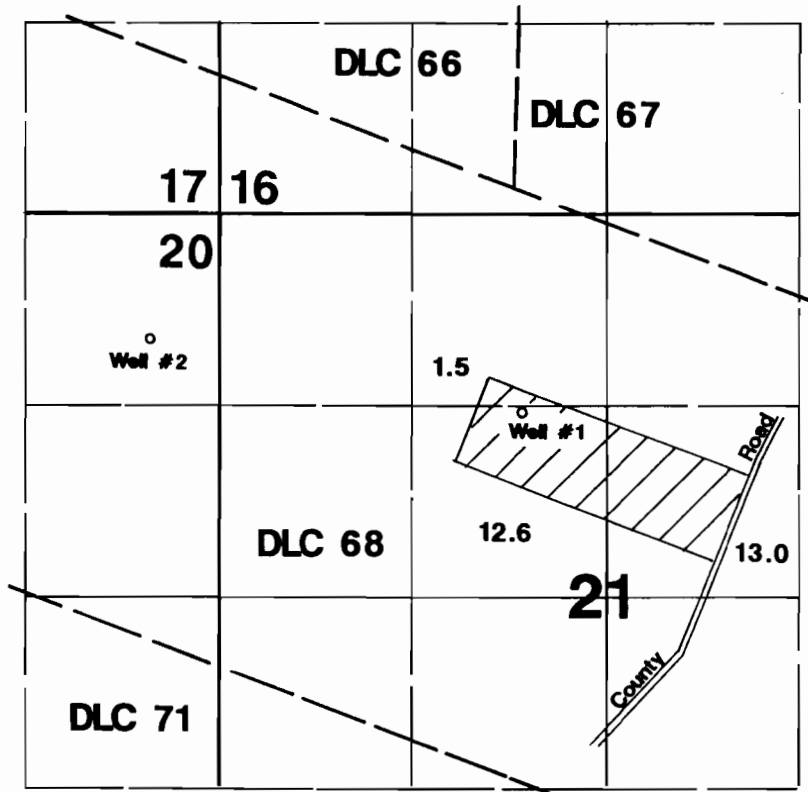

Well #1 located 1360'S & 2070'E from NW corner Section 21.  
Well #2 located 870'S & 460'W from NE corner Section 20.

## Final Proof Survey

Application #: G-12899

Permit #: G-12257

In Name Of

# Terry & Deborah Beilke

Surveyed on July 11, 1996 by James Grimm

