


T29S R4W WM
SECTION 22

THIS MAP TO BE
USED FOR WATER RIGHT
PURPOSES ONLY.

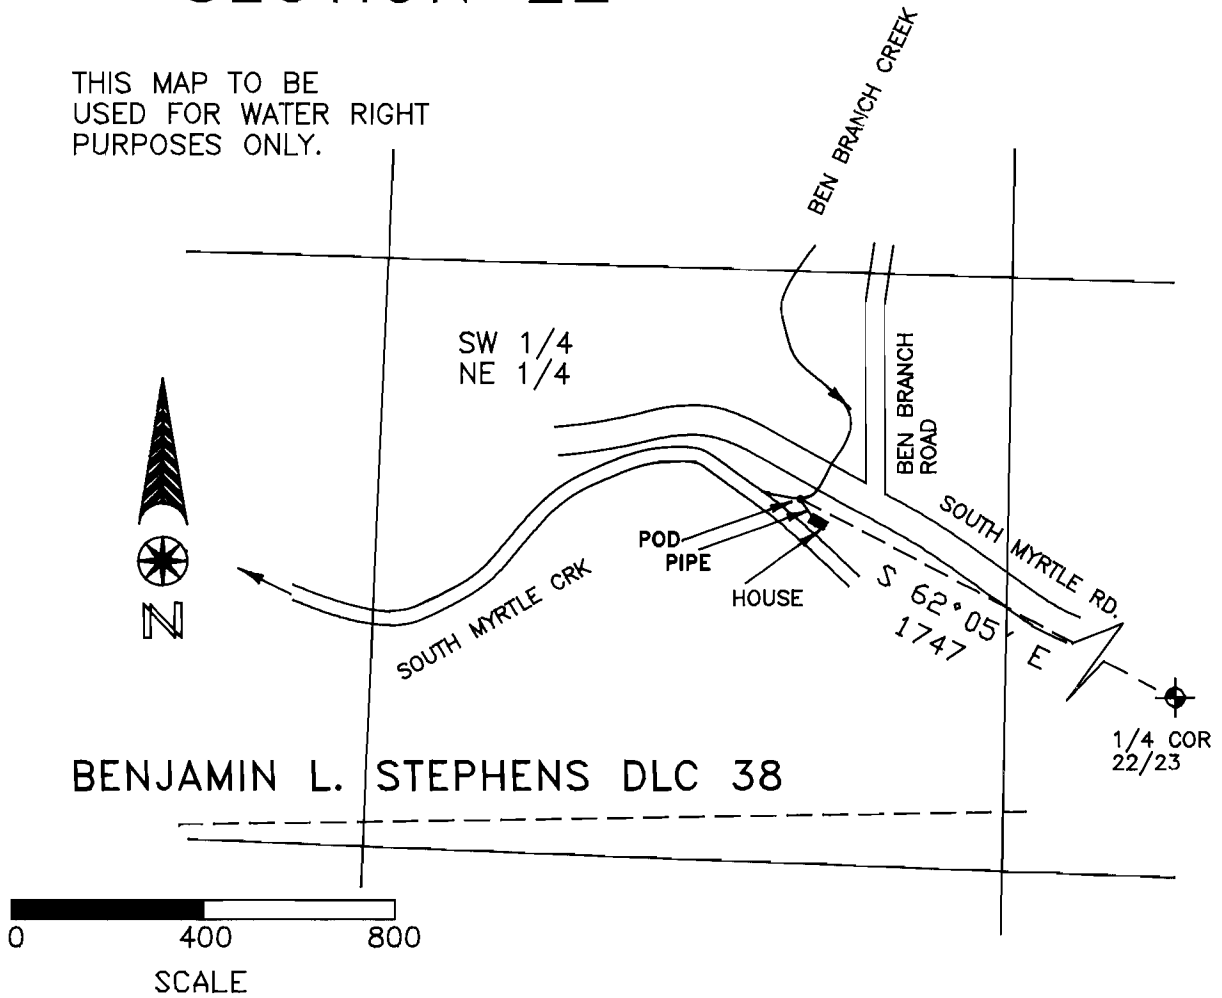

FINAL PROOF SURVEY
IN NAME OF *Robert F. Smith*

APPLICATION S-71994, PERMIT 52147
9/7/96

BY: WILLIAM J. RUPPERT
P.O. BOX 1564
MYRTLE CREEK, OR 97457

