


T1N.R.3W.W.M.

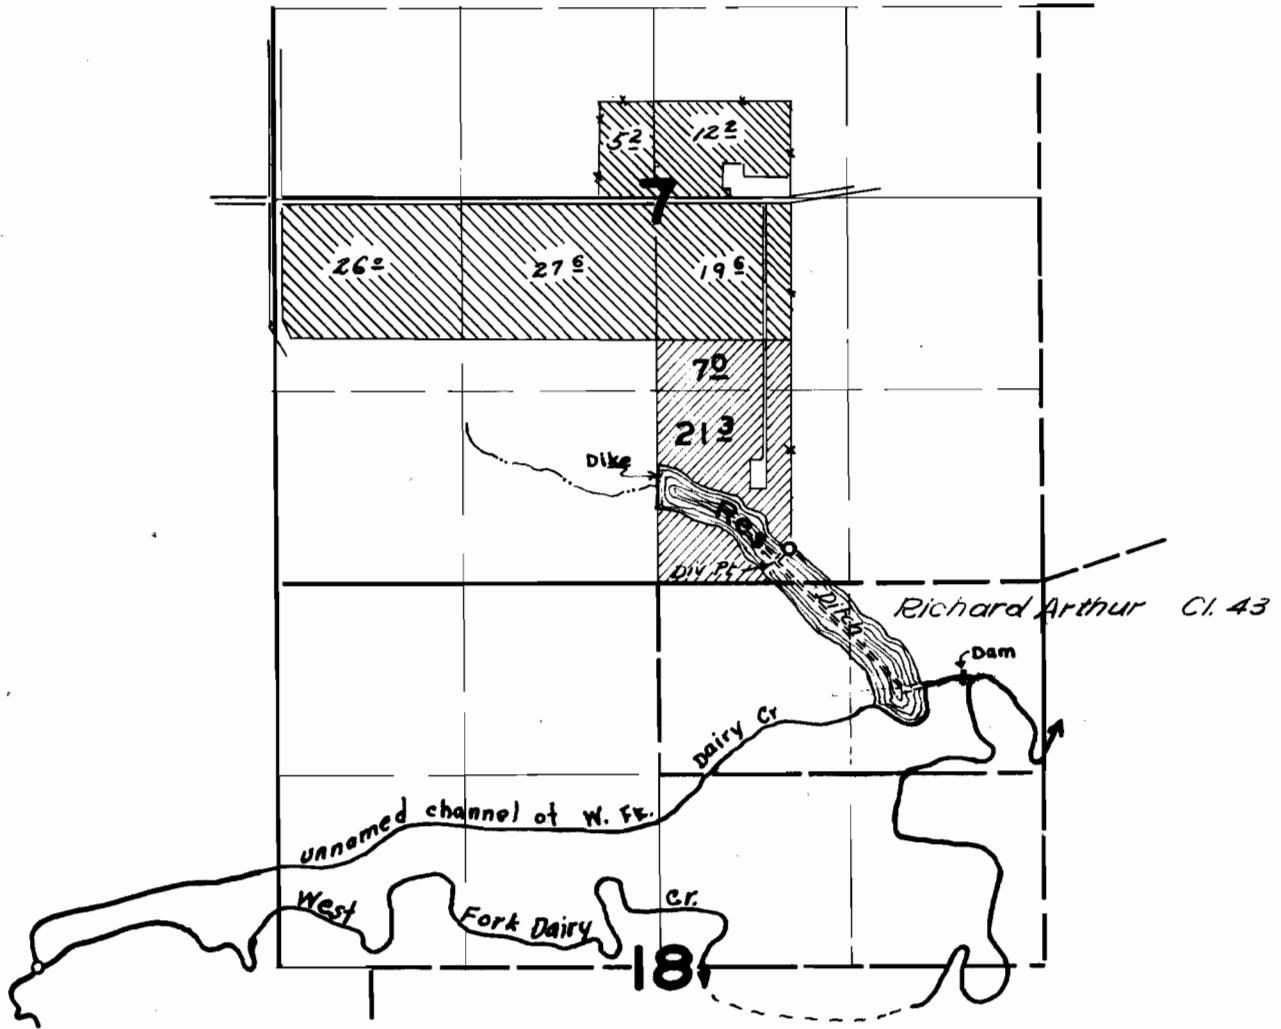

FINAL PROOF SURVEY

UNDER

24371

21234

Application No. 24372

Permit No. 19231

IN NAME OF

A.I. & P.E. VANDEHEY

EDWARD W. VANDEHEY, SUNDEN

April 17 1956

R. H. WHITBY

Surveyed June 11, 1952, by

CONFIDENTIAL

1952 C

DFR-3D-186

C# 23463
C# 22018