


T. 1N. R. 3W. W.M.

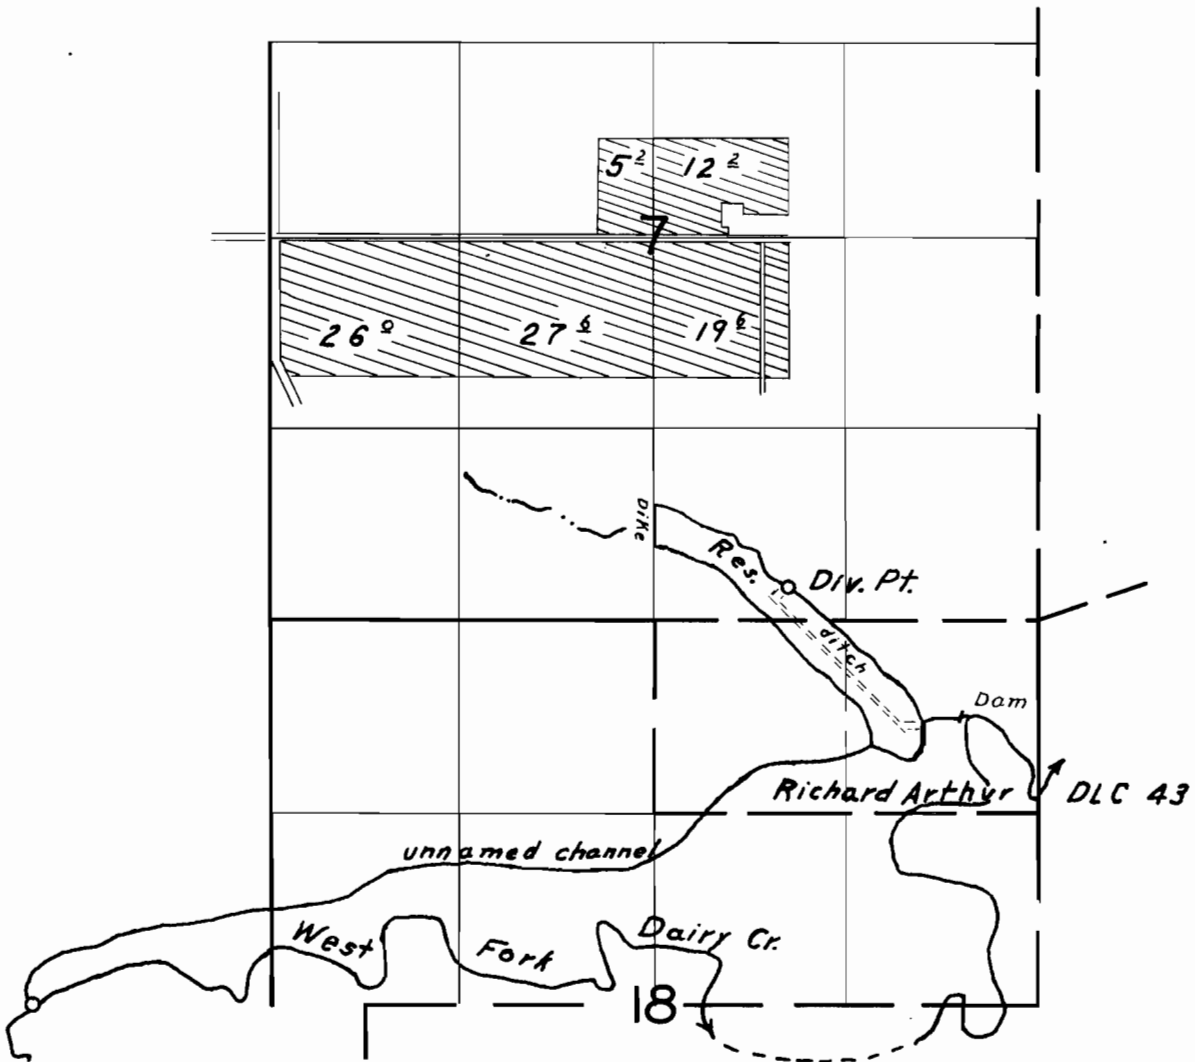

FINAL PROOF SURVEY
UNDER

R-29603 R-1834
Application No. 29745 Permit No. 24064
IN NAME OF

Edward Vanderzanden

Surveyed April 30 1958, by R.H. Whithy